IREDELL COUNTY HEALTH DEPARTMENT

STATESVILLE 704-878-5305 (C) MOORESVILLE 704-664-5281

IMPROVEMENT PERMIT / AUTHORIZATION TO CONSTRUCT / OPERATION PERMIT / EXISTING SYSTEM INSPECTION

PERMIT# 102095 PIN# 4892-79-5848 DATE 9-6-01

OWNER OR CONTRACTOR Jimmy TUCKER PHONE: Business _____ Home (336) 463-5575

ADDRESS 2833 WYO RD YADKINVILLE NC 27055

LOCATION US 21 N, TR POWELL RD, TL TURKEYFOOT RD, TR SANDY SPRINGS RD, TL JOYNER RD, 4th MH on (R) BEFORE END

SUBDIVISION Jimmy TUCKER BLOCK / SECTION _____ LOT 8 LOT AREA 0.57 ACRE SITE CLASS PS DESIGN FLOW 360 L.T.A.R. 0.30 GPD/FT²

Septic Tank: 1000 Gallons; STB 620 Date 3-25-02
Pump Tank: _____ Gallons; PT _____ Date _____
Pump Make: _____ Model _____ Serial No. _____
Nitrification Field: No Fields 1 Square Feet 1200 Linear Feet 400
No Lines FIVE Trench Width 36" Max Trench Bottom Depth 36" Gravel Depth 12"

☑ New System ☐ Repair System Type: I (II) III IV V VI
System Description: CONVENTIONAL GRAVITY
Repair System Description: 50% REDUCTION, PUMP
Maintenance Agreement Required: ☐ Yes ☑ No
☐ Slab ☐ Crawl Space ☐ Basement w/plumbing ☐ Basement wo/plumbing


☐ House/Mod. Home No. Bedrooms 3
☑ Mobile Home No. Bathrooms 2
☐ Business No. Employees _____
☐ Other _____

Water Supply:
☐ Individual
☐ Public
☐ Community

Comments/Conditions:

Comments/Conditions: SEPTIC TANK WITH MARKER INSTALLED USING "ZABEL" FILTER

INITIAL SITE SKETCH

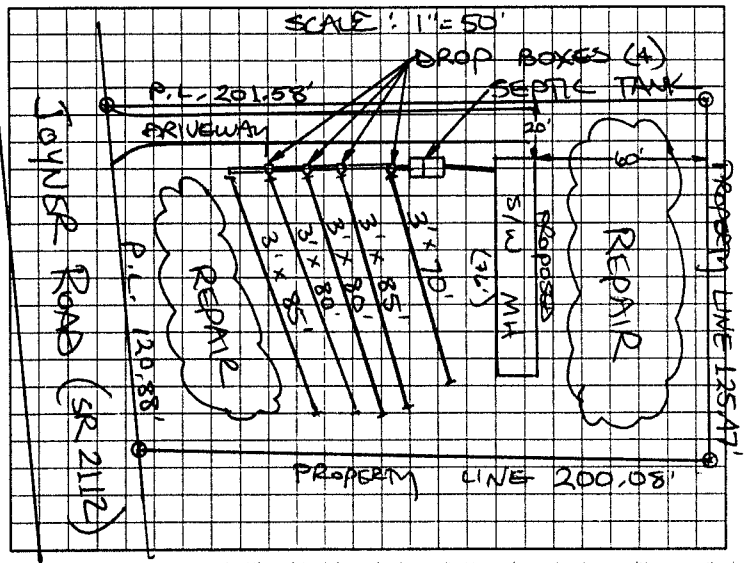

AS BUILT SKETCH

SYSTEM INSTALLED ACCORDING TO INITIAL SITE SKETCH

Permit can be suspended or revoked if any false information is supplied toward securing the permit/any unauthorized changes are made to the site/any unauthorized changes are made in the installation of the system. Improvement Permit with plat valid without expiration. Improvement Permit with site plan valid for sixty months. Authorization to Construct is valid for a period equal to that of Improvement Permit – not to exceed sixty months.

Signed: Jimmy Tucker date 9-6-01

Improvement Permit by: STEVE HEDRICK date 9-6-01

Authorization to Construct by: STEVE HEDRICK date 9-6-01

Installed by: COURTNEY GENERAL CONSTRUCTION

Operation Permit by: STEVE HEDRICK date 7-15-02

Existing System Inspection by: _____ date _____

HEALTH DEPT. COPY: WHITE OWNER COPY (FINAL): YELLOW OWNER COPY (INITIAL): PINK