IREDELL COUNTY HEALTH DEPARTMENT - *ENVIRONMENTAL HEALTH* ☑ STATESVILLE OFFICE 704-878-5305 ☐ MOORESVILLE OFFICE 704-664-5281

IMPROVEMENT PERMIT / AUTHORIZATION TO CONSTRUCT / OPERATION PERMIT / EXISTING SYSTEM INSPECTION

PERMIT # 174357 PIN # 4893086388 DATE 8-22-12

OWNER Phil Duggan APPLICANT: Same PHONE: Home/Cell # 704-546-2208 Business # N/A

SITE ADDRESS 230 Renegar Rd. OWNER / APPLICANT ADDRESS 230 Renegar Rd.

SITE DIRECTIONS 21N TR E. Houstonville Rd TL Sandy Springs Rd TL Renegar Rd.

SUBDIVISION N/A BLOCK / SECTION N/A LOT # N/A LOT AREA 9.0 acres DESIGN FLOW 600gpd L.T.A.R. 0.3

Septic Tank Existing Gallons: STB ____ Date ____

Pump Tank ____ Gallons: P T ____ Date ____

Pump Make ____ Model ____ Serial # ____

No. Nitrification Fields: 1 No. Lines 5 Linear Feet 500

Trench Width 36" Max. Trench Bottom Depth Existing Gravel Depth N/A

☐ New System ☐ Repair ☐ Expansion System Type I II ☒ III IV V VI

System Description: 25% Reduction

Repair System Description: Conventional

Maintenance Agreement Required ☐ YES ☑ NO

☑ GRAVITY ☐ PRESSURE

☑ Residence No. Bedrooms 5

☐ Business No. Persons ____

☐ Other No. Employees ____

☑ Slab ☐ Crawl Space

☐ Basement w/plumbing ☐ Basement w/o plumbing

Water Supply


☑ Private

☐ Public


☐ Community

Comments / Conditions

INITIAL SITE SKETCH

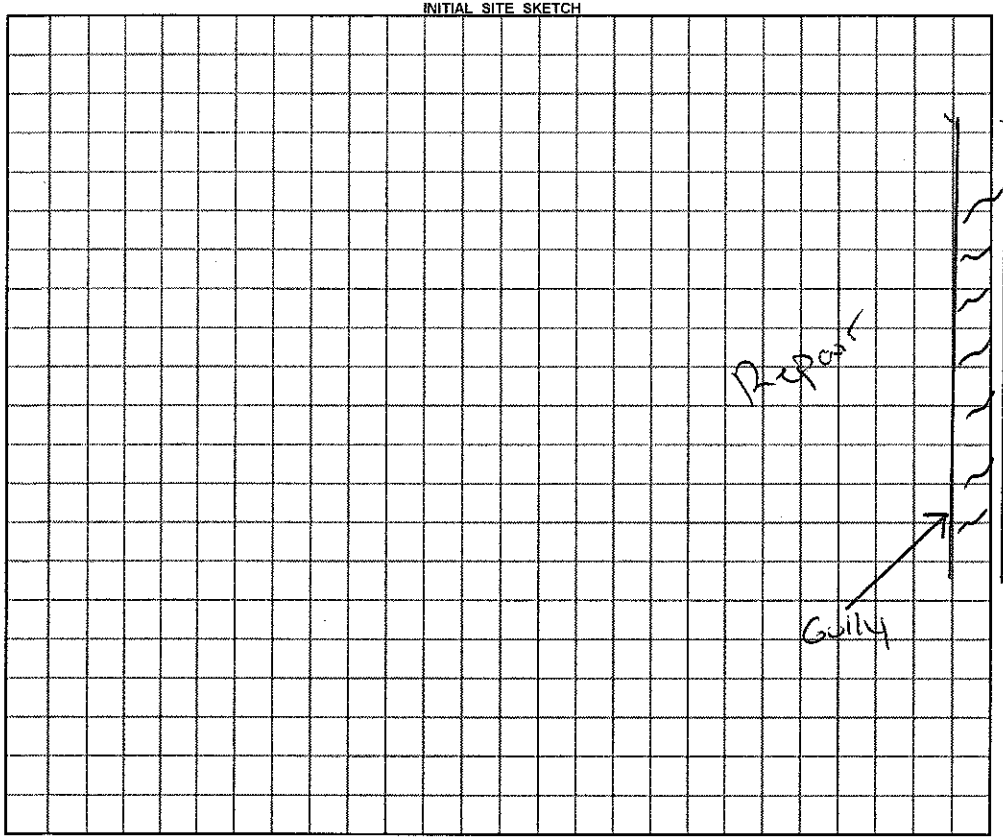

AS BUILT SKETCH

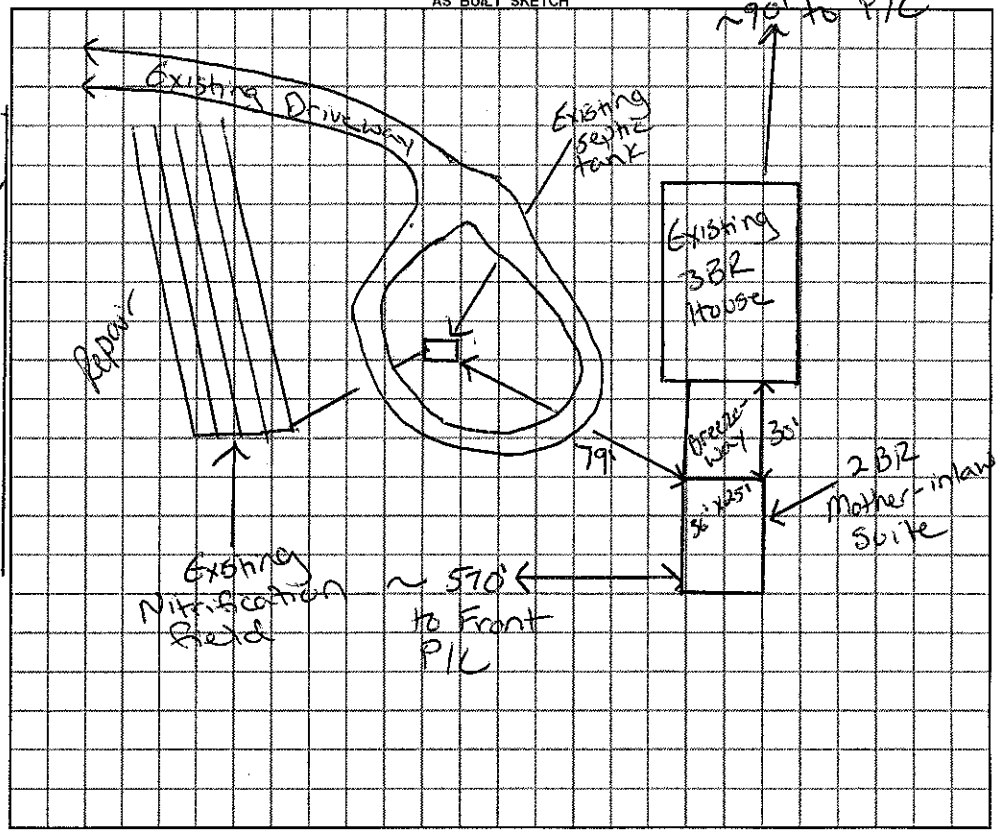

Permit can be suspended or revoked if any false information is supplied toward securing the permit / any unauthorized changes are made to the site / any unauthorized changes are made in the installation of the system.

☐ ***IMPROVEMENT PERMIT*** *with plat valid without expiration.* ☐ ***IMPROVEMENT PERMIT*** *with ~~plat valid without expiration.~~ site plan valid 60 mo.* ☐ ***AUTHORIZATION TO CONSTRUCT*** valid for period equal to IMPROVEMENT PERMIT--not to exceed 60 mo.

Owner / Applicant Signature: ____ Date ____ Installed by: ____

IMPROVEMENT PERMIT by: ____ ***REHS*** Date ____ OPERATION PERMIT by: ____ ***REHS*** Date ____

AUTHORIZATION TO CONSTRUCT by: ____ ***REHS*** Date ____ Existing System Inspected by: Justin Henderson ***REHS*** Date 8-22-12

YOU SHOULD CONTACT A LOCATOR SERVICE PRIOR TO ANY EXCAVATION

White Copy – Environmental Health YELLOW COPY (Final) Owner / Applicant PINK COPY (Initial) Owner / Applicant