IREDELL COUNTY HEALTH DEPARTMENT

STATESVILLE 704-878-5305 (C1) MOORESVILLE 704-664-5281

IMPROVEMENT PERMIT / AUTHORIZATION TO CONSTRUCT / OPERATION PERMIT / EXISTING SYSTEM INSPECTION

PERMIT# 107558 PIN# 4893-11-3975 DATE 7-26-02

OWNER OR CONTRACTOR MICHAEL P. STOUT PHONE Business Home 704-546-5218

ADDRESS 2608 SANDY SPRINGS ROAD, HARMONY, NC 28634

LOCATION US 21 N, TR E. HOUSTONVILLE RD, TO END, LOT DIRECTLY ACROSS AT 2608 SANDY SPRINGS RD.

SUBDIVISION BLOCK / SECTION LOT LOT AREA 1.78 ACRES SITE CLASS PS DESIGN FLOW 360 L.T.A.R. 0.30 GPD/FT²

Septic Tank: 1000 Gallons: STB 760 Date 5-27-02
Pump Tank: Gallons: PT Date
Pump Make: Model Serial No.
Nitrification Field: No Fields 1 Square Feet 1200 Linear Feet 400
No Lines FIVE Trench Width 36" Max Trench Bottom Depth 36" Gravel Depth 12"

☑ New System ☐ Repair System Type: I II III IV V VI
System Description: CONVENTIONAL, GRAVITY
Repair System Description: CONVENTIONAL, GRAVITY
Maintenance Agreement Required: ☐ Yes ☑ No
☐ Slab ☑ Crawl Space ☐ Basement w/plumbing ☐ Basement wo/plumbing


☐ House/Mod. Home No. Bedrooms 3
☐ Mobile Home No. Bathrooms 2
☐ Business No. Employees
☐ Other

Water Supply:
☑ Individual
☐ Public
☐ Community
WELL NEXT DOOR


Comments/Conditions: KEEP SYSTEM MINIMUM 100 FEET FROM WELL

Comments/Conditions: SEPTIC TANK WITH MARKER INSTALLED USING "ZABEL" FILTER

INITIAL SITE SKETCH

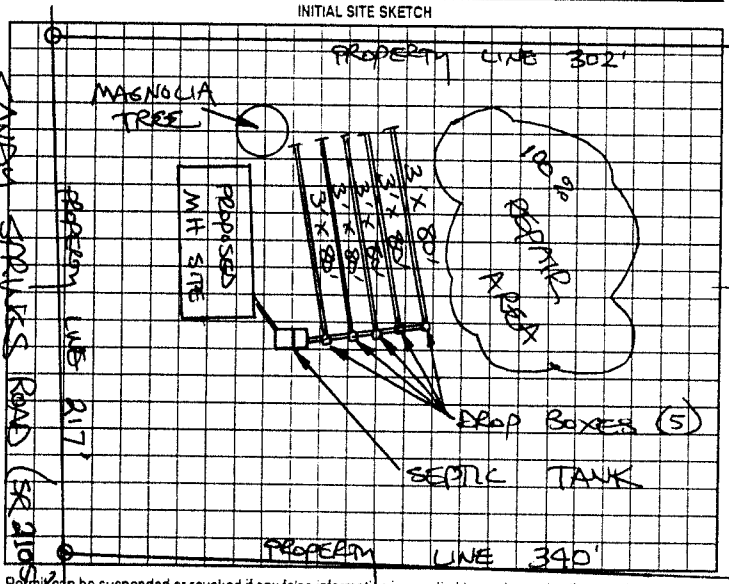

AS BUILT SKETCH

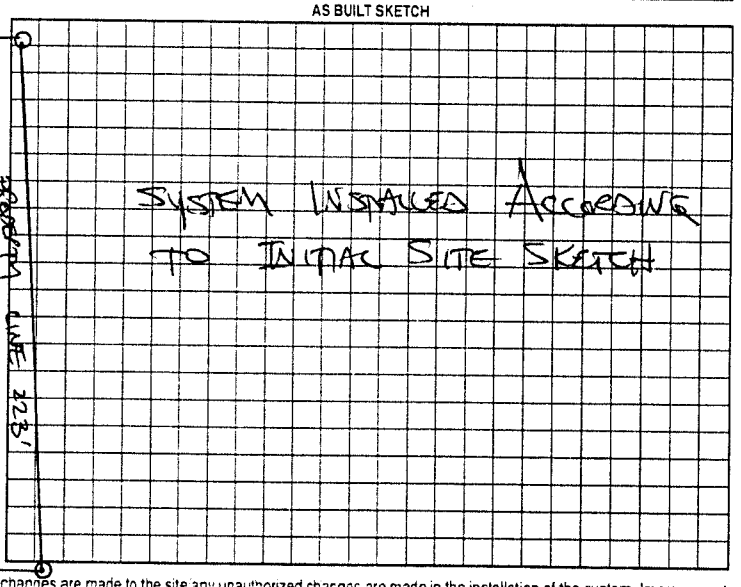

Permit can be suspended or revoked if any false information is supplied toward securing the permit/any unauthorized changes are made to the site/any unauthorized changes are made in the installation of the system. Improvement Permit with plat valid without expiration. Improvement Permit with site plan valid for sixty months. Authorization to Construct is valid for a period equal to that of Improvement Permit - not to exceed sixty months

Signed: [signature] date 7-26-02 installed by: BILLY GRIMES

Improvement Permit by: STEVE HEDRICK date 7-26-02 Operation Permit by: STEVE HEDRICK date 8-28-02

Authorization to Construct by: STEVE HEDRICK date 7-26-02 Existing System Inspection by: date

E. HOUSTONVILLE ROAD (SR 2115) HEALTH DEPT COPY: WHITE OWNER COPY (FINAL): YELLOW OWNER COPY (INITIAL): PINK