IREDELL COUNTY HEALTH DEPARTMENT

Statesville Phone TR 3-7271 Mooresville Phone NO 3-1271

PERMIT TO INSTALL SEPTIC TANK

Permit NO._____ Permit Date June 11 19 66

Owner Gardner Stout Address Harmony

Installed By C Hoke Address RJ


Location of Property Right Houstonville at Mayberry Stn - Cross River at steel bridge go to next intersection - left short way on R -

Tank		Capacity		Length of Lines		Fixtures	
Block	( )	1000	( )	225'	( )	No. of Baths	( )
Precast	( )	1250	( )	250'	( )	Dishwasher	( )
		1500	( )	Other_____		Garbage Grdr.	( )
		Other_____				Other_____	

NOTIFY HEALTH DEPARTMENT AT LEAST EIGHT HOURS BEFORE TANK IS TO BE INSPECTED.

Final Inspection_____ 19___ Approved ( ) Disapproved ( )

Remarks well 55'

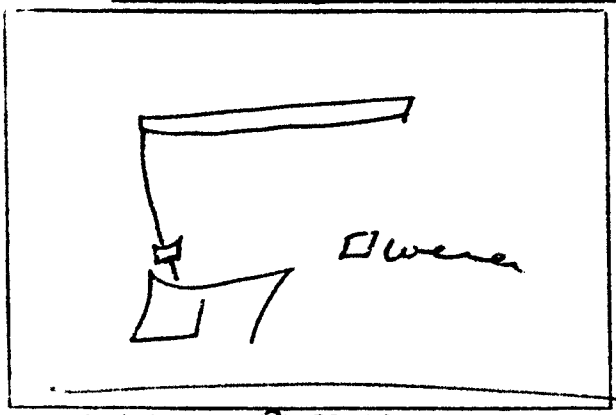

Sketch of Installation

Sanitarian