IREDELL COUNTY HEALTH DEPARTMENT

Statesville Phone TR 3-7271 Mooresville Phone NO 3-1271

PERMIT TO INSTALL SEPTIC TANK

Permit NO. _____ Permit Date FEB 12 1959

Owner PAUL JOINER Address RT #2 HARMONY

Installed By SELF Address _____


Location of Property HP #21 PAST HARMONY GO TO MAY BERRY'S STORE TURN RIGHT GO ABOUT 3 MILES TO INTERSECTION TURN LEFT

Tank		Capacity		Length of Lines		Fixtures	
Block	( )	800	( )	150'	( )	No. of Baths	ONE (1)
Precast	(✓)	900	( )	175'	( )	Dishwasher	( )
		1000	(✓)	200'	( )	Garbage Grdr.	( )
		1100	( )	225'	( )	Auto-Washer	( )
		1200	( )	250'	( )	Other	_____
		Other	_____	Other	80'X 40"		

NOTIFY HEALTH DEPARTMENT AT LEAST EIGHT HOURS BEFORE TANK IS TO BE INSPECTED.

Final Inspection FEB 12 1959 Approved (✓) Disapproved ( )

Remarks EXCELLENT JOB —

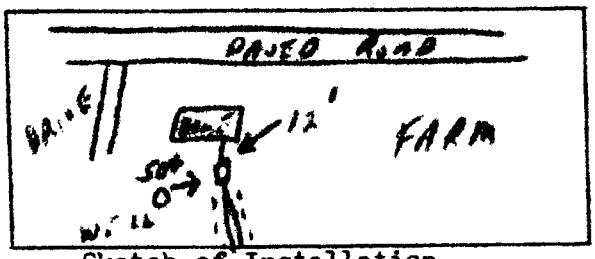

Sketch of Installation

Raford G Horner

Sanitarian