IREDELL COUNTY HEALTH DEPARTMENT

STATESVILLE 704-878-5305 MOORESVILLE 704-664-5281

IMPROVEMENT PERMIT / CERTIFICATE OF COMPLETION / OPERATION PERMIT / EXISTING SYSTEM INSPECTION

PROPERTY DESCRIPTION NO. 21503 DATE 8-8-95 TAX MAP NO. 17Q-A-24 Watershed: ☐ Yes ☒ No

OWNER OR CONTRACTOR PAUL JOYNER PHONE: Business _____ Home 546-7738

ADDRESS 2710 SANDY SPRINGS ROAD HARMONY NC 28634

LOCATION US 21 N, TR HOUSTONVILLE RD, TL SANDY SPRINGS RD, TR PATRICK RD, 2ND MH ON LEFT

SUBDIVISION _____ BLOCK / SECTION _____ LOT _____ LOT AREA AMPLE SITE CLASS PS DESIGN FLOW 360 L.T.A.R. EXISTING

Septic Tank: EXISTING Gallons; STB _____ Date _____

Pump Tank: _____ Gallons; PT _____ Date _____

Pump Make: _____ Model _____ Serial No. _____

Nitrification Field: No Fields 1 Square Feet _____ Linear Feet EXISTING

No Lines _____ Trench Width _____ Max Trench Bottom Depth _____ Gravel Depth _____

☐ New System ☐ Repair System Type: ☒ I ☐ II, IV, V, VI

System Description: CONV. GRAVITY

Repair System Description: _____

Maintenance Agreement Required: ☐ Yes ☒ No

☐ House/Mod. Home No. Bedrooms 3

☒ Mobile Home No. Bathrooms 2

☐ Business No. Employees ____

☐ Other _____


☐ Slab ☐ Crawl Space ☐ Basement w/plumbing ☐ Basement wo/plumbing

Water Supply: ☒ Individual ☐ Community ☐ Public WELL


Comments:

Comments: KEEP MH MINIMUM 5' FROM SYSTEM

INITIAL SITE SKETCH

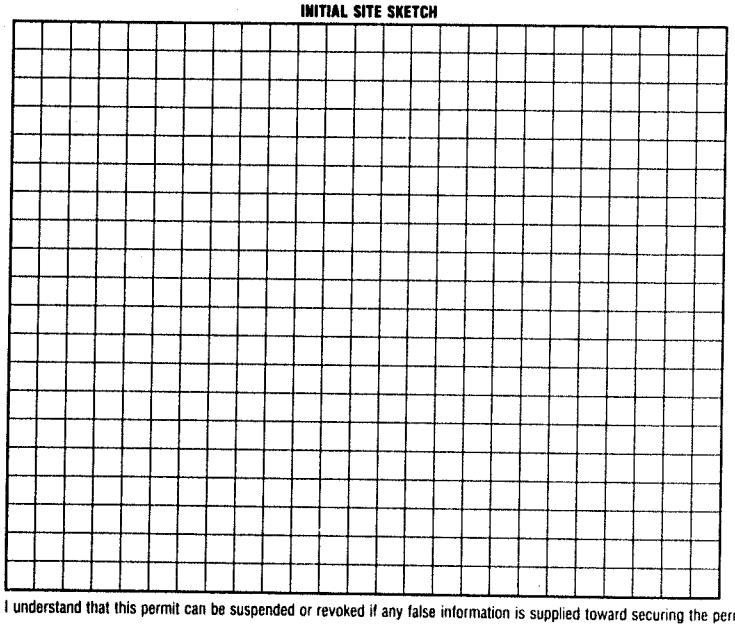

AS BUILT SKETCH

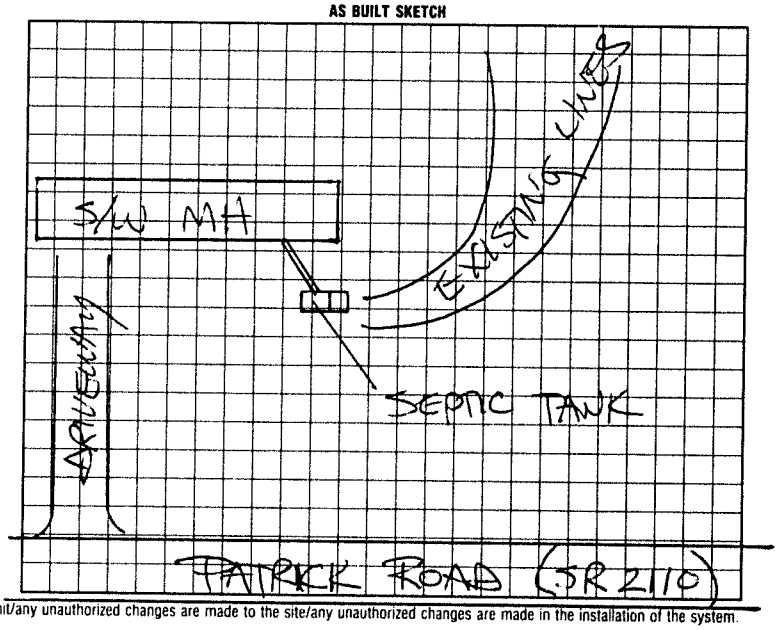

I understand that this permit can be suspended or revoked if any false information is supplied toward securing the permit/any unauthorized changes are made to the site/any unauthorized changes are made in the installation of the system.

Signed: _____

Improvement Permit by: _____ date _____

Existing System Inspection by: STEVE HEDRICK date 8-8-95

Installed by: _____

Certificate of Completion by: _____ date _____

Operation Permit by: _____ date _____

HEALTH DEPT. COPY: WHITE INSPECTION COPY (FINAL): GREEN OWNER COPY (FINAL): YELLOW INSPECTION COPY (INITIAL): PINK OWNER COPY (INITIAL): GOLD