IREDELL COUNTY HEALTH DEPARTMENT

Statesville Phone TR 3-7271 Mooresville Phone NO 3-1271

PERMIT TO INSTALL SEPTIC TANK

Permit Date Jan 23 1964

Permit NO. _____

Owner Sandy Springs Resort Address _____

Installed By Roy Lentz Address Statesville

Location of Property Two miles south of Town


Hickory on Sheffield Rd. on left

Tank		Capacity		Length of Lines		Fixtures	
Block	( )	800	( )	150'	( )	No. of Baths	( ) 1½
Precast	( )	900	( )	175'	( )	Dishwasher	( )
Pound		1000	( )	200'	( )	Garbage Grdr.	( )
		1100	( )	225'	( )	Auto-Washer	( )
		1200	( )	250'	( )	Other	_____
		Other	_____	Other	_____		

NOTIFY HEALTH DEPARTMENT AT LEAST EIGHT HOURS BEFORE TANK IS TO BE INSPECTED.

Final Inspection 1-23 1964 Approved ( ) Disapproved ( )

Remarks _____

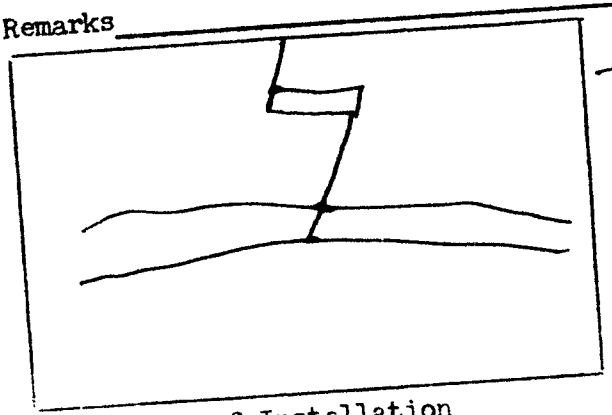

Sketch of Installation

water on other Property

R.A.

Sanitarian