IREDELL COUNTY HEALTH DEPARTMENT

STATESVILLE 704-878-5305 MOORESVILLE 704-664-5281

IMPROVEMENT PERMIT / CERTIFICATE OF COMPLETION / OPERATION PERMIT / EXISTING SYSTEM INSPECTION

PROPERTY DESCRIPTION NO. 25854 DATE 12-27-96 TAX MAP NO. 4893-46-0672 Watershed: III Yes No

OWNER OR CONTRACTOR DEAN HUTCHINS PHONE: Business Home (910) 463-4263

ADDRESS 223 AMBERHILL ROAD, YADKINVILLE NC 27055

LOCATION US 21 N, TR E. HOUSTONVILLE RD, TL SANDY SPRINGS RD, TR AMBERHILL RD, ~0.5 MILE ON LEFT #223

SUBDIVISION BLOCK / SECTION LOT LOT AREA 5 ACRES SITE CLASS PS DESIGN FLOW 240 L.T.A.R. EXISTING

Septic Tank: EXISTING Gallons; STB Date

Pump Tank: Gallons; PT Date

Pump Make: Model Serial No.

Nitrification Field: No Fields Square Feet Linear Feet EXISTING

No Lines Trench Width Max Trench Bottom Depth Gravel Depth

☐ New System ☐ Repair System Type: I, II, III, IV, V, VI

System Description: CONV. GRAVITY

Repair System Description:

Maintenance Agreement Required: ☐ Yes ☑ No

☐ Slab ☑ Crawl Space ☐ Basement w/plumbing ☐ Basement wo/plumbing

☐ House/Mod. Home No. Bedrooms 3

☑ Mobile Home No. Bathrooms 2

☐ Business No. Employees


☐ Other

Water Supply:
☑ Individual
☐ Community
☐ Public
WELL


Comments:

Comments: KEEP MH MINIMUM 5' FROM SYSTEM

INITIAL SITE SKETCH

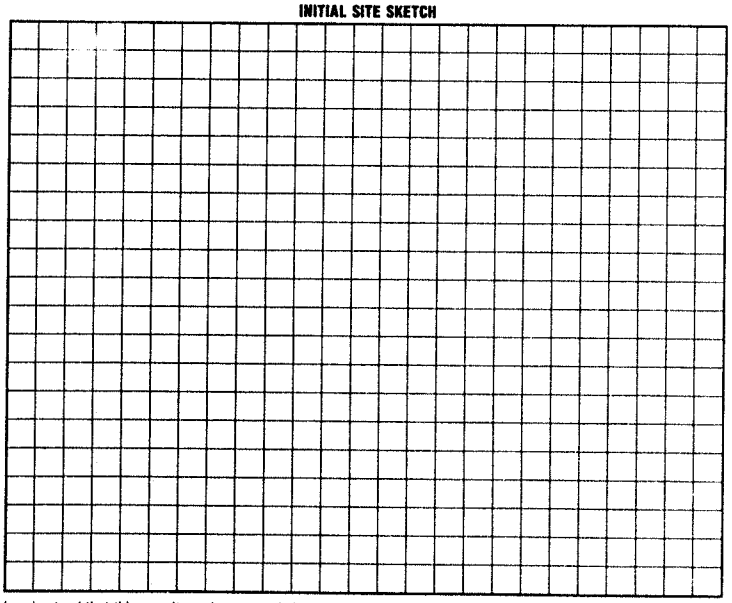

AS BUILT SKETCH

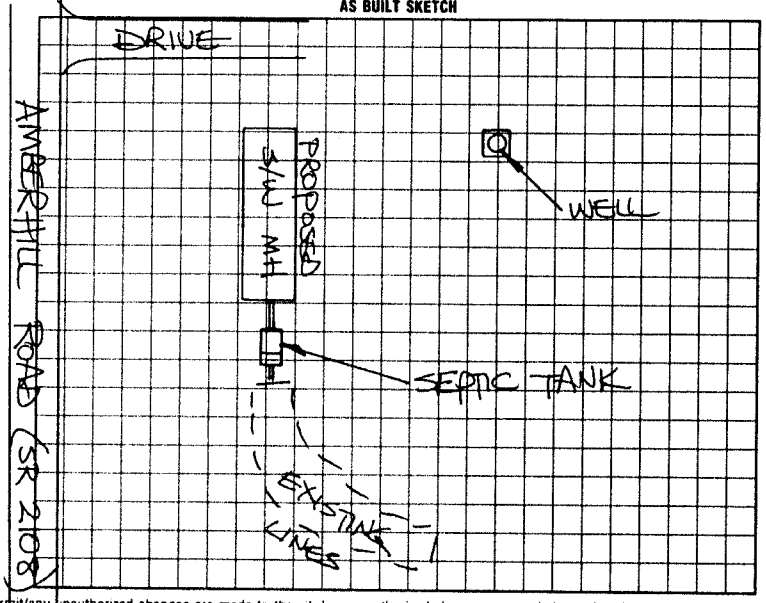

I understand that this permit can be suspended or revoked if any false information is supplied toward securing the permit/any unauthorized changes are made to the site/any unauthorized changes are made in the installation of the system. Improvement Permit is valid for 60 months from date of issuance.

Signed:

Improvement Permit by: date

Existing System Inspection by: STEVE HEDRICK date 12-27-96

Installed by:

Certificate of Completion by: date

Operation Permit by: date

HEALTH DEPT. COPY: WHITE INSPECTION COPY (FINAL): GREEN OWNER COPY (FINAL): YELLOW INSPECTION COPY (INITIAL): PINK OWNER COPY (INITIAL): GOLD