IREDELL COUNTY HEALTH DEPARTMENT

STATESVILLE 704-878-5305 MOORESVILLE 704-664-5281

IMPROVEMENT PERMIT / AUTHORIZATION TO CONSTRUCT / OPERATION PERMIT / EXISTING SYSTEM INSPECTION

PERMIT# ~~091989~~ 123021 PIN# 4893 47 4815 DATE October 2, 2002

OWNER OR CONTRACTOR Roger Horne PHONE: Business 336-998-1966 Home

ADDRESS P.O. Box 52 Harmony NC 28634

LOCATION 21N TR Houstonville Rd. TL Sandy Springs Rd. TR Amberhill Rd. .6 mile on left @ orange gates

SUBDIVISION BLOCK / SECTION LOT LOT AREA 18 Acres SITE CLASS. RS DESIGN FLOW 240gpd L.T.A.R. N.3 drainfield area

Septic Tank: 1000 Gallons; STB 760 Date 9-1-02
Pump Tank: Gallons; PT Date
Pump Make: Model Serial No.
Nitrification Field: No Fields 1 Square Feet 810 Linear Feet 270
No Lines 3 @ 90' Trench Width 36" Max Trench Bottom Depth 36" Gravel Depth 12"

☑ New System ☐ Repair System Type: I, II, III, IV, V, VI
System Description: Gravity conventional
Repair System Description: same
Maintenance Agreement Required: ☐ Yes ☑ No

☑ House/Mod. Home No. Bedrooms 2
☐ Mobile Home No. Bathrooms 2
☐ Business No. Employees
☐ Other


Water Supply: ☑ Individual ☐ Public ☐ Community

☐ Slab ☑ Crawl Space ☐ Basement w/plumbing ☐ Basement wo/plumbing


Comments:/Conditions: 1563.06'

Comments:/Conditions: ① SEPTIC TANK WITH MARKER INSTALLED USING "ZABEL" FILTER ② CHROMA 2 MOTTLES NOTED IN BACKFILL AT TIME OF INSPECTION.

INITIAL SITE SKETCH

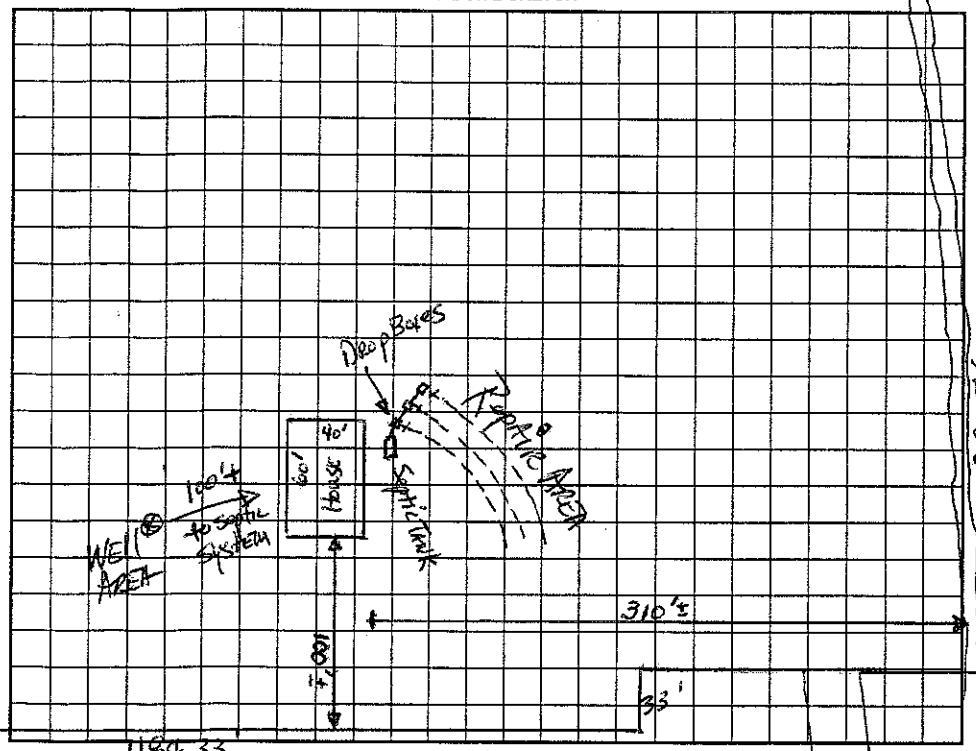

AS BUILT SKETCH

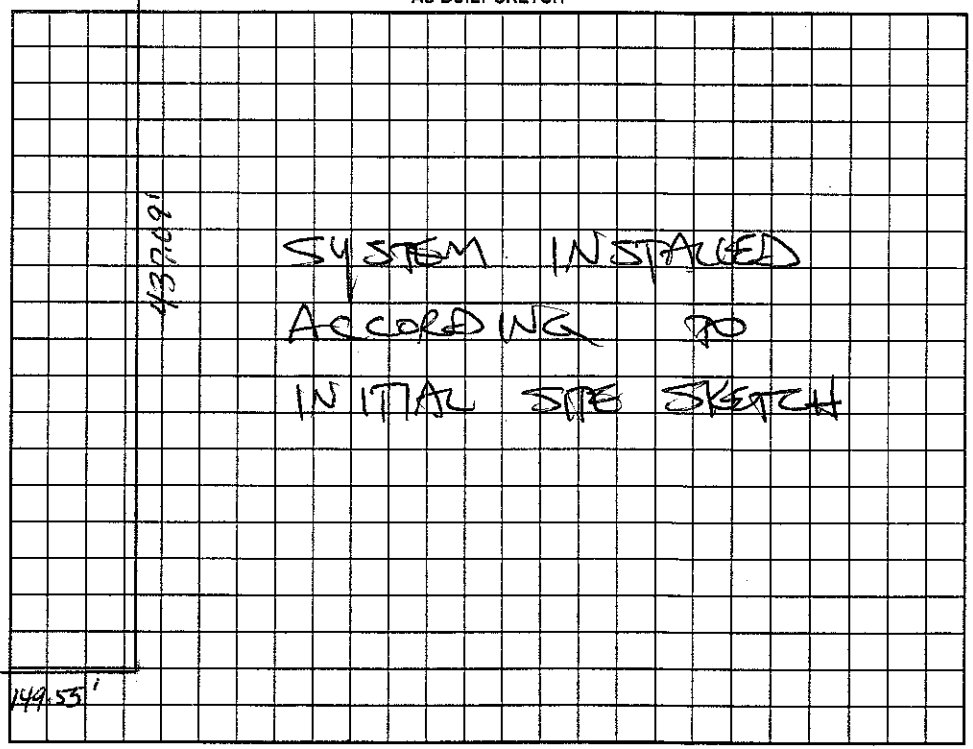

Permit can be suspended or revoked if any false information is supplied toward securing the permit/any unauthorized changes are made to the site/any unauthorized changes are made in the installation of the system. Improvement Permit with plat valid without expiration. Improvement Permit with site plan valid for sixty months. Authorization to Construct is valid for a period equal to that of Improvement Permit – not to exceed sixty months.

Signed: date Installed by: BRENT GARDNER

Improvement Permit by: date 10-2-00 Operation Permit by: STEVE HEDRICK date 3-13-03

Authorization to Construct by: date 10-2-00 Existing System Inspection by: date

HEALTH DEPT. COPY: WHITE OWNER COPY (FINAL): YELLOW OWNER COPY (INITIAL): PINK