IREDELL COUNTY HEALTH DEPARTMENT *ENVIRONMENTAL HEALTH DIVISION:*

SITE PLAN WORKSHEET

SEE THE "SAMPLE SITE PLAN" BELOW. ***INCOMPLETE SITE PLANS WILL BE RETURNED TO YOU FOR COMPLETION AND MAY RESULT IN A DELAY IN THE ISSUANCE OF YOUR SEPTIC SYSTEM PERMIT!!!***

Place an (X) beside each item as you complete the site plan:

____ Property Line measurements are clearly identified... **____ All proposed structures are indicated...**

SHOW: proposed house or business footprint, wells, water lines, patios, pools and decks, and any other item that will occupy space on the site


____ Front and side setbacks from property line... **____ Preferred driveway location and configuration, preferred well location...**

____ Area you prefer your septic system to be placed... **____ North arrow, or other sufficient indicator of direction...**


Circle N/A on the following if appropriate:

____ Location of septic systems and wells within 100' of your property... N/A

____ Location of easements and rights of ways on your property... N/A **____ Location of any designated wetlands on the property... N/A**

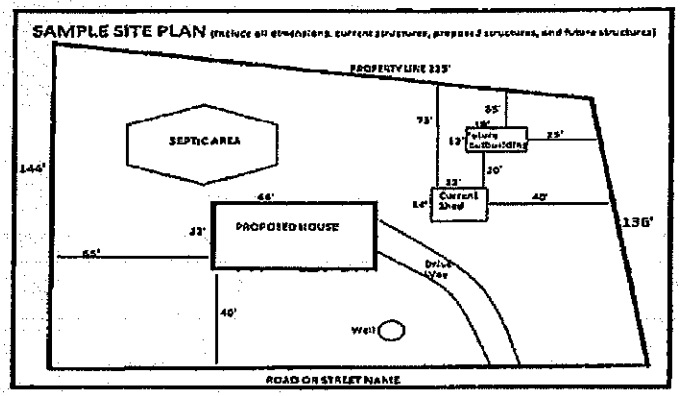

USE THIS SPACE TO DRAW YOUR SITE PLAN

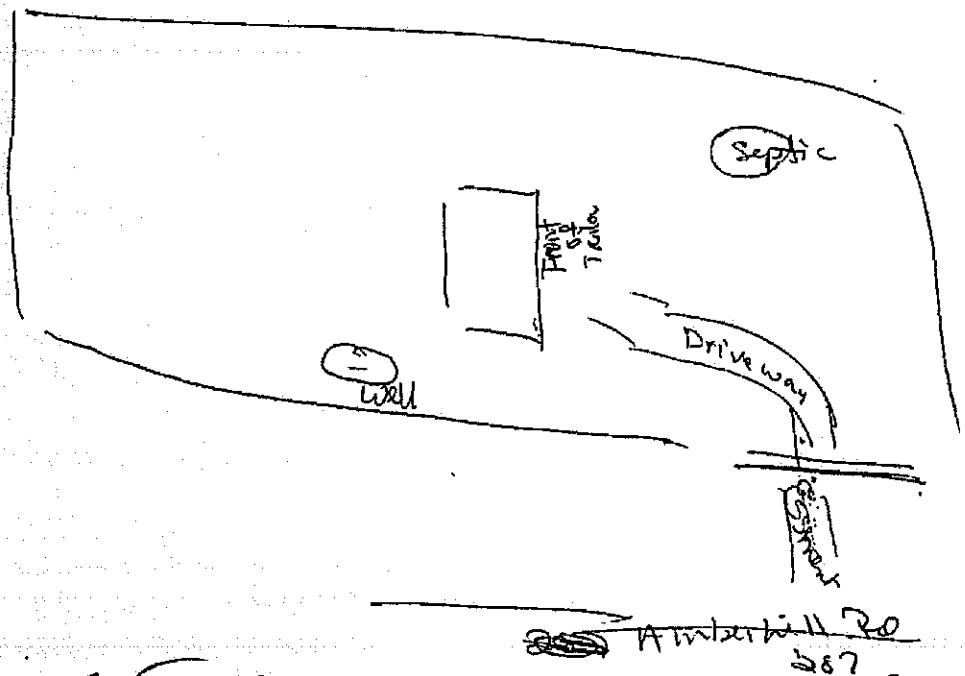

Signature: Amber Horne

REQUIRED **property owner or owner's legal representative signature.**

9-26-16

DATE

IREDELL COUNTY HEALTH DEPARTMENT

STATESVILLE 704-878-5305 MOORESVILLE 704-664-5281

IMPROVEMENT PERMIT / AUTHORIZATION TO CONSTRUCT / OPERATION PERMIT / EXISTING SYSTEM INSPECTION

PERMIT# ~~091989~~ 123021 PIN# 4893 47 4815 DATE October 2, 2000

OWNER OR CONTRACTOR Roger Howard PHONE: Business 336-998-1966 Home

ADDRESS P.O. Box 52 Harmony NC 28634

LOCATION 2 IN TR Houstonville Rd. TL Sandy Springs Rd. TR Amberhill Rd. .6 mile on left @ orange gates

SUBDIVISION BLOCK / SECTION LOT LOT AREA 18 Acres SITE CLASS. RS DESIGN FLOW 240gpd L.T.A.R. N.3 drainfield AREA

Septic Tank: 1000 Gallons; STB 760 Date 9-1-02
Pump Tank: Gallons; PT Date
Pump Make: Model Serial No.
Nitrification Field: No Fields 1 Square Feet 810 Linear Feet 270
No Lines 3 @ 90' Trench Width 36" Max Trench Bottom Depth 36" Gravel Depth 12"

☑ New System ☐ Repair System Type: I, II, III, IV, V, VI
System Description: Gravity conventional
Repair System Description: same
Maintenance Agreement Required: ☐ Yes ☑ No


☑ House/Mod. Home No. Bedrooms 2
☐ Mobile Home No. Bathrooms 2
☐ Business No. Employees
☐ Other

☐ Slab ☑ Crawl Space ☐ Basement w/plumbing ☐ Basement wo/plumbing

Water Supply: ☑ Individual ☐ Public ☐ Community


Comments/Conditions: 1563.06'

INITIAL SITE SKETCH

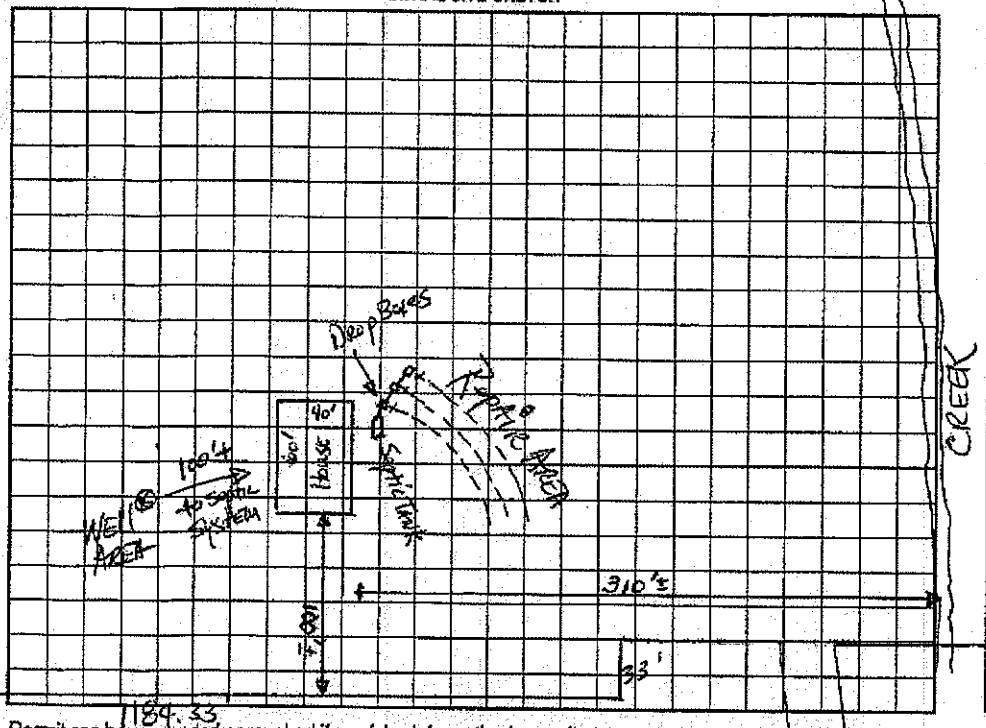

Comments/Conditions: ① SEPTIC TANK WITH MARKER INSTALLED USING "ZABEL" FILTER ② CHROMA 2 MOTTLES NOTED IN BACKFILL AT TIME OF INSPECTION.

AS BUILT SKETCH

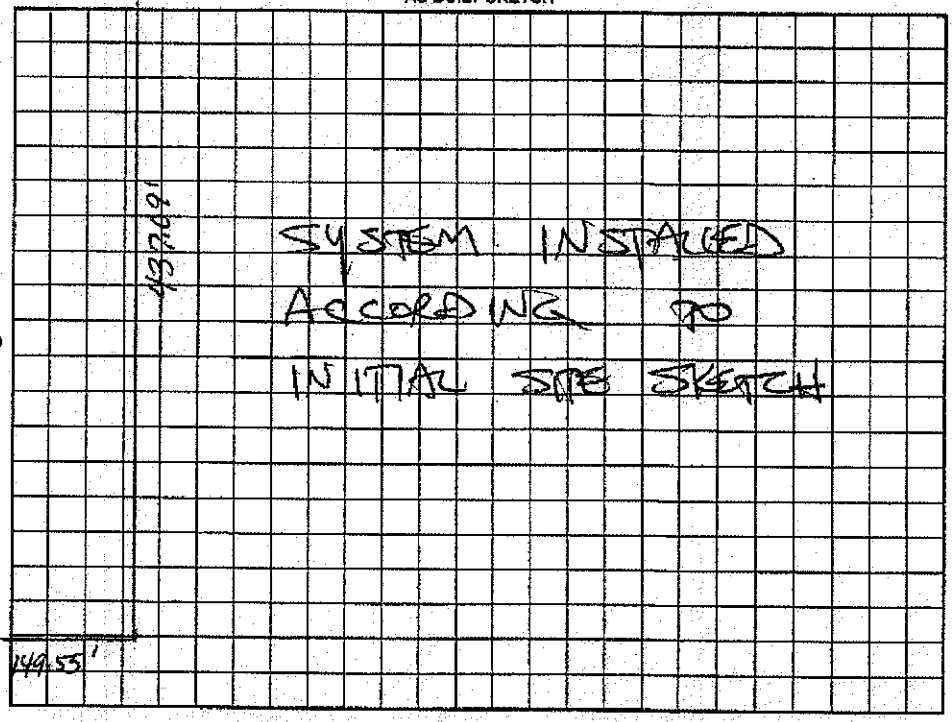

Permit can be suspended or revoked if any false information is supplied toward securing the permit/any unauthorized changes are made to the site/any unauthorized changes are made in the installation of the system. Improvement Permit with plat valid without expiration. Improvement Permit with site plan valid for sixty months. Authorization to Construct is valid for a period equal to that of Improvement Permit – not to exceed sixty months.

Signed: Roger Howard

Improvement Permit by: date 10-2-00

Authorization to Construct by: date 10-2-00

Installed by: BRENT GARDNER

Operation Permit by: STEVE HENDRICK date 3-13-03

Existing System Inspection by: date

HEALTH DEPT. COPY: WHITE OWNER COPY (FINAL): YELLOW OWNER COPY (INITIAL): PINK

556.38