IREDELL COUNTY HEALTH DEPARTMENT

STATESVILLE 704-878-5305 MOORESVILLE 704-664-5281

IMPROVEMENT PERMIT / AUTHORIZATION TO CONSTRUCT / OPERATION PERMIT / EXISTING SYSTEM INSPECTION

PERMIT# 080585 PIN# 4893 70 7088 DATE 5-13-99

OWNER OR CONTRACTOR JIMMY TUCKER PHONE: Business (910) 463-2658 Home

ADDRESS 3833 WYO ROAD, YADKINVILLE NC 27055

LOCATION US 21N, TR E. HOUSTONVILLE RD, TR SANDY SPRINGS RD, TL DOBY RD TR JOYNER RD, 2ND ON (L)

SUBDIVISION JIMMY TUCKER BLOCK / SECTION III LOT 5 LOT AREA 0.71 ACRE SITE CLASS PS DESIGN FLOW 360 L.T.A.R. 0.30 SPD/FT 2

Septic Tank: 1000 Gallons; STB 238 Date 4-1-99
Pump Tank: Gallons; PT Date
Pump Make: Model Serial No.
Nitrification Field: No Fields 1 Square Feet 1200 Linear Feet 400
No Lines FIVE Trench Width 36" Max Trench Bottom Depth 30" Gravel Depth 12"

☑ New System ☐ Repair System Type: I (II) III IV V VI
System Description: CONVENTIONAL GRAVITY
Repair System Description: PPBPS, GRAVITY
Maintenance Agreement Required: ☐ Yes ☑ No


☐ House/Mod. Home ☑ Mobile Home ☐ Business ☐ Other
No. Bedrooms 3 No. Bathrooms 2 No. Employees
☐ Slab ☑ Crawl Space ☐ Basement w/plumbing ☐ Basement wo/plumbing

Water Supply: ☑ Individual ☐ Public ☐ Community WELL

Comments/Conditions:

PROPERTY LINE 208.00' (GOING)

INITIAL SITE SKETCH

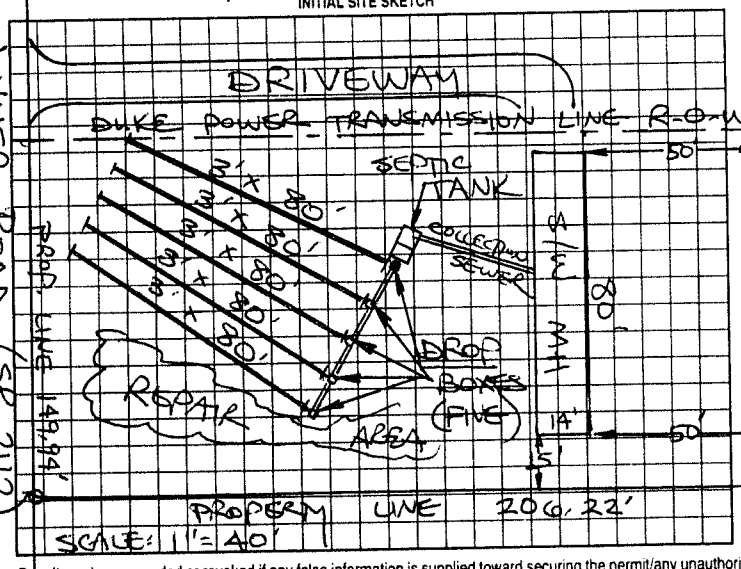

Comments/Conditions: SYSTEM INSPECTED 5-21-99
~~RISERS OR MARKER REMAINS TO BE INSTALLED ON TANK~~
SEPTIC TANK W/ ~~COVER~~ RISERS INSTALLED

AS BUILT SKETCH

SYSTEM INSTALLED ACCORDING TO INITIAL SITE SKETCH

Permit can be suspended or revoked if any false information is supplied toward securing the permit/any unauthorized changes are made to the site/any unauthorized changes are made in the installation of the system. Improvement Permit with plat valid without expiration. Improvement Permit with site plan valid for sixty months. Authorization to Construct is valid for a period equal to that of Improvement Permit – not to exceed sixty months.

Signed: date

Improvement Permit by: STEVE HEDRICK date 5-13-99

Authorization to Construct by: STEVE HEDRICK date 5-13-99

Installed by: COWSNEY GENERAL CONSTRUCTION

Operation Permit by: STEVE HEDRICK date 6-11-01

Existing System Inspection by: date

HEALTH DEPT COPY WHITE OWNER COPY (FINAL) YELLOW OWNER COPY (INITIAL) PINK