IREDELL COUNTY HEALTH DEPARTMENT

STATESVILLE 704-878-5305 MOORESVILLE 704-664-5281

IMPROVEMENT PERMIT / AUTHORIZATION TO CONSTRUCT / OPERATION PERMIT / EXISTING SYSTEM INSPECTION

PERMIT# 19995 PIN# 4893703370 DATE 5-1-08

OWNER OR APPLICANT Jimmy Tucker PHONE: Business _____ Home 336-463-5575

ADDRESS 2833 Wyo Rd Yadkinville NC 27055

LOCATION US 21N @ E. Houstonville (R) Sandy Springs (L) Dolby RD (R) Jayne

SUBDIVISION Jimmy Tucker BLOCK / SECTION _____ LOT 5 LOT AREA 1.77 SITE CLASS. PB DESIGN FLOW 360 L.T.A.R. 3

Septic Tank: 1000 Gallons: STB 238 Date 4-1-99
Pump Tank: _____ Gallons: PT _____ Date _____
Pump Make: _____ Model _____ Serial No. _____
Nitrification Field: No Fields 1 Square Feet 900 Linear Feet 460
No Lines 5 Trench Width 36 Max Trench Bottom Depth 30" Gravel Depth 12" ☐ Gravity ☐ Pressure

☐ ~~New System~~ ☐ Repair ☐ Expansion System Type: I II III IV V VI
System Description: Conventional Gravity
Repair System Description: 50% Low Pressure
Maintenance Agreement Required: ☐ Yes ☐ No

☒ House/Mod. Home No. Bedrooms 3
☐ Mobile Home No. Persons ____
☐ Business No. Employees ____
☐ Other _____


Water Supply: ☐ Individual ☐ Public ☐ Community

☐ Slab ☒ Crawl Space ☐ Basement w/plumbing ☐ Basement wo/plumbing


Comments/Conditions:

Comments/Conditions:
Original System Inspected 5-21-99
Septic Tank w/ Risers installed

INITIAL SITE SKETCH

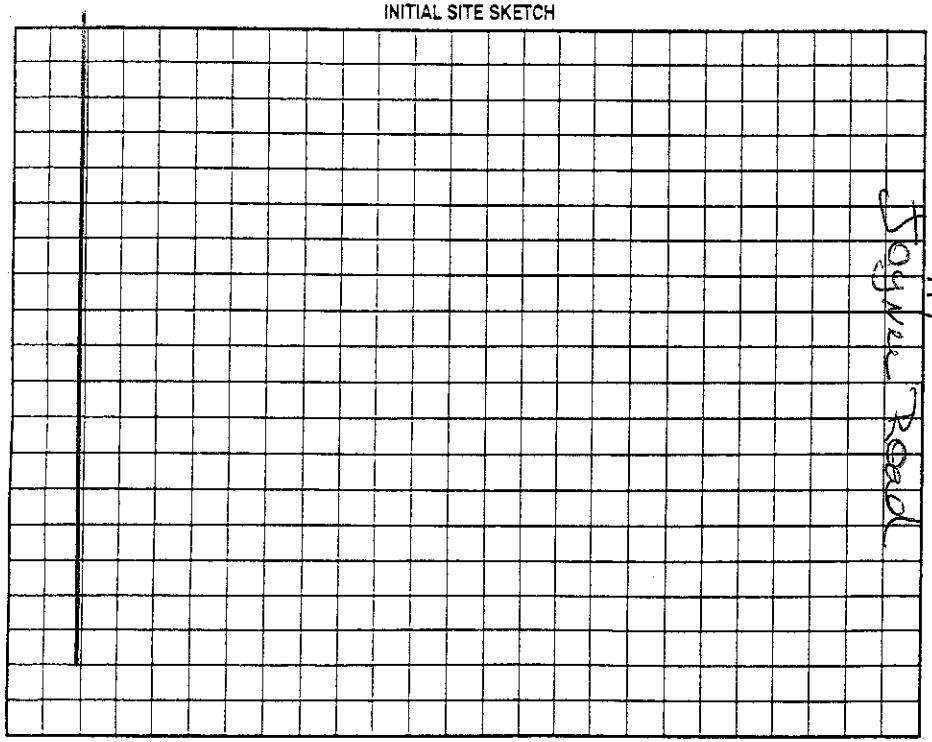

AS-BUILT SKETCH

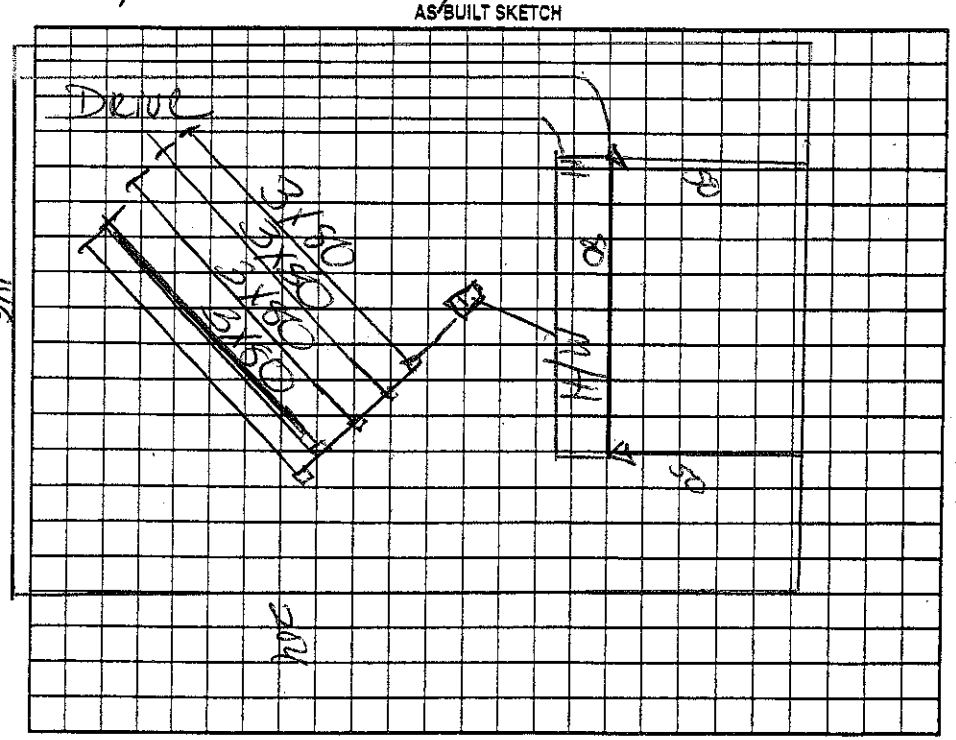

Permit can be suspended or revoked if any false information is supplied toward securing the permit/any unauthorized changes are made to the site/any unauthorized changes are made in the installation of the system. Improvement Permit with plat valid without expiration ☐ Improvement Permit with site plan valid for sixty months ☒ Authorization to Construct is valid for a period equal to that of Improvement Permit – not to exceed sixty months.

Signed: _____ date _____ Installed by: _____

Improvement Permit by: _____ date _____ Operation Permit by: _____ date _____

Authorization to Construct by: _____ date _____ Existing System Inspection by: Kelly Cook date 5-1-08

HEALTH DEPT. COPY: WHITE OWNER COPY (FINAL): YELLOW OWNER COPY (INITIAL): PINK