IREDELL COUNTY HEALTH DEPARTMENT

STATESVILLE 704-878-5305 MOORESVILLE 704-664-5281

IMPROVEMENT PERMIT / AUTHORIZATION TO CONSTRUCT / OPERATION PERMIT / EXISTING SYSTEM INSPECTION

PERMIT# 066705 PIN# 4893 70 7185 DATE 5-13-99

OWNER OR CONTRACTOR Jimmy Tucker PHONE: Business (910) 463-2658 Home

ADDRESS 2833 WYO ROAD YADKINVILLE, NC 27055

LOCATION US 21 N, TR E. HOUSTONVILLE RD, TR SANDY SPRINGS, TL BOBBY RD, ON, RIGHT AT JOYNER RD.

SUBDIVISION Jimmy Tucker BLOCK / SECTION 1 LOT 1 LOT AREA 0.98 ACRE SITE CLASS PS DESIGN FLOW 360 L.T.A.R. 0.30 9.20 192

Septic Tank: 1000 Gallons; STB 238 Date 4-16-99
Pump Tank: ____ Gallons; PT ____ Date ____
Pump Make: ____ Model ____ Serial No. ____
Nitrification Field: No Fields 1 Square Feet EQ. TO 1200 Linear Feet 300+
No Lines FIVE Trench Width 36 Max Trench Bottom Depth 30"

☐ New System ☐ Repair System Type: I, II, III, IV, V, VI
System Description: 25% REDUCTION GRAVITY
Repair System Description: 50% REDUCTION
Maintenance Agreement Required: ☐ Yes ☐ No
Gravel Depth 6" STONE ☐ Slab ☐ Crawl Space ☐ Basement w/plumbing ☐ Basement wo/plumbing


☐ House/Mod. Home No. Bedrooms 3
☐ Mobile Home No. Bathrooms 2
☐ Business No. Employees ____
☐ Other ____

Water Supply: ☒ Individual ☐ Public ☐ Community


Comments/Conditions: INSTALL 25% REDUCTION SYSTEM USING FIFTY (50) CHAMBERS OR THIRTY (30) H.D.S. SECTIONS

Comments/Conditions: LINES INSPECTED OK 6-7-99 RSH
SEPTIC TANK WITH RISERS INSTALLED USING "POLYLOK" FILTER

INITIAL SITE SKETCH

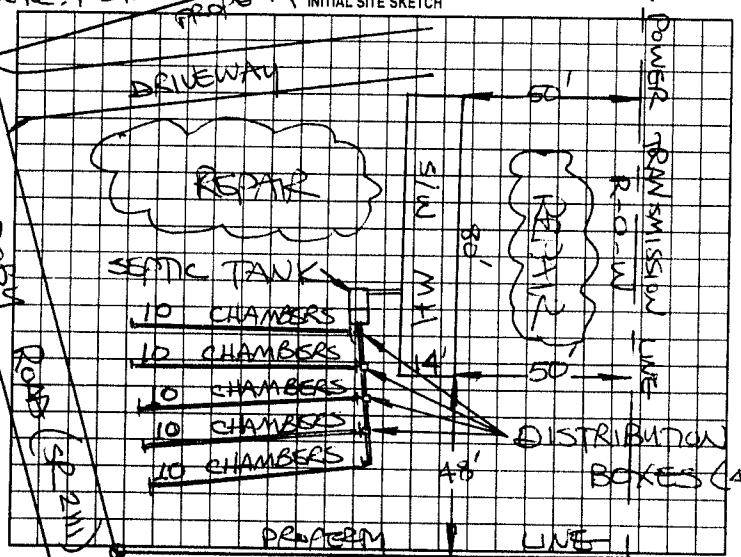

AS BUILT SKETCH

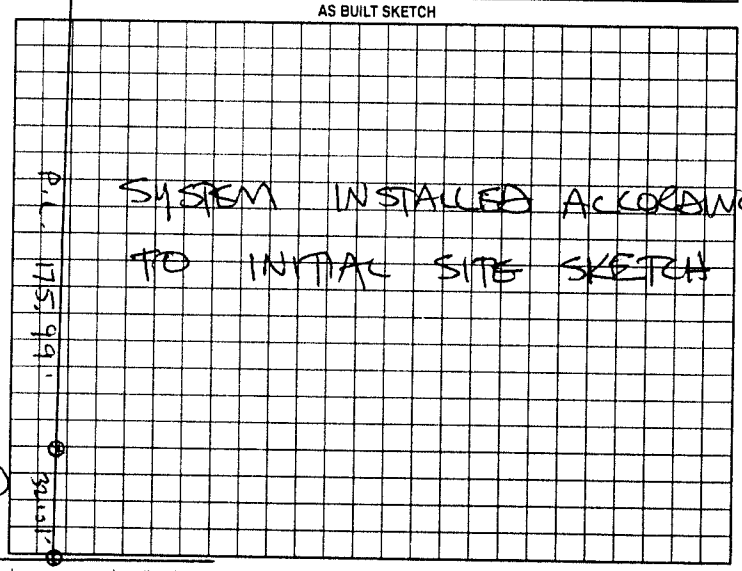

Permit can be suspended or revoked if any false information is supplied toward securing the permit/any unauthorized changes are made to the site/any unauthorized changes are made in the installation of the system. Improvement Permit with plat valid without expiration. Improvement Permit with site plan valid for sixty months. Authorization to Construct is valid for a period equal to that of Improvement Permit – not to exceed sixty months.

Signed: Jimmy W Tucker date 5-17-99

Improvement Permit by: STEVE HEDRICK date 5-13-99

Authorization to Construct by: STEVE HEDRICK date 5-13-99

Installed by: JOYNER ROAD (SR 2112) COURTNEY GENERAL CONSTRUCTION

Operation Permit by: STEVE HEDRICK date 6-11-99

Existing System Inspection by: ____ date ____

HEALTH DEPT COPY WHITE OWNER COPY (FINAL) YELLOW OWNER COPY (INITIAL) PINK