IREDELL COUNTY HEALTH DEPARTMENT

STATESVILLE 704-878-5305 MOORESVILLE 704-664-5281

IMPROVEMENT PERMIT / AUTHORIZATION TO CONSTRUCT / OPERATION PERMIT / EXISTING SYSTEM INSPECTION

PERMIT# 066706 PIN# 4893 70 7185 DATE 5-13-99

OWNER OR CONTRACTOR JIMMY TUCKER PHONE: Business (910) 463-2658 Home

ADDRESS 2833 NW 6 ROAD TROUTMAN NC 28166

LOCATION US 21 N TR E. HOUSTONVILLE RD TR SNOW SPRINGS RD TL DEBY RD, 2ND LOT ON (R) PAST JOYNER

SUBDIVISION JIMMY TUCKER BLOCK / SECTION 1 LOT 2 LOT AREA 0.68 ACRE SITE CLASS FS DESIGN FLOW 360 L.T.A.R. 0.30 GPD/FT²

Septic Tank: 1000 Gallons; STB 238 Date 3-1-99
Pump Tank: Gallons; PT Date
Pump Make: Model Serial No.
Nitrification Field: No Fields 1 Square Feet 50 TO 1200 Linear Feet 300
No Lines FIVE Trench Width 36" Max Trench Bottom Depth 24"

(X) New System ( ) Repair System Type: I, II, (III), IV, V, VI
System Description: 2012 HORIZ. HDS SPAN
Repair System Description: 50% REDUCTION
Maintenance Agreement Required: ( ) Yes (X) No
Gravel Depth N/A ( ) Slab (X) Crawl Space ( ) Basement w/plumbing ( ) Basement wo/plumbing


( ) House/Mod. Home No. Bedrooms 3
(X) Mobile Home No. Bathrooms 2
( ) Business No. Employees
( ) Other

Water Supply: (X) Individual ( ) Public ( ) Community


Comments/Conditions: INSTALL 25% REDUCTION SYSTEM USING THIRTY (30) H.D.S. SECTIONS IN 2012 HORIZONTAL CONFIGURATION

Comments/Conditions: SEPTIC TANK WITH RISERS AND "POLY LOK" FILTER INSTALLED

INITIAL SITE SKETCH SCALE: 1" = 40'

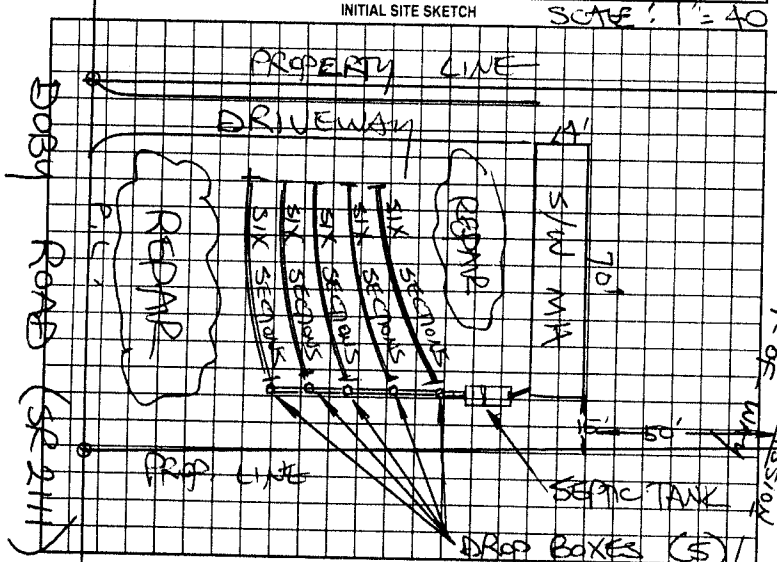

AS BUILT SKETCH

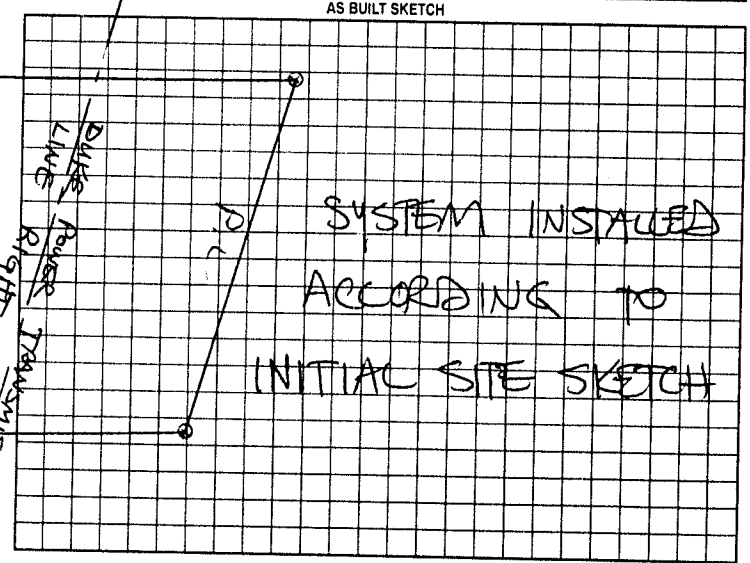

Permit can be suspended or revoked if any false information is supplied toward securing the permit/any unauthorized changes are made to the site/any unauthorized changes are made in the installation of the system. Improvement Permit with plat valid without expiration. Improvement Permit with site plan valid for sixty months. Authorization to Construct is valid for a period equal to that of Improvement Permit – not to exceed sixty months.

Signed: Jimmy Tucker date 5-17-99

Improvement Permit by: STEVE HEDRICK date 5-13-99

Authorization to Construct by: STEVE HEDRICK date 5-13-99

Installed by: COURTNEY GENERAL CONSTRUCTION

Operation Permit by: STEVE HEDRICK date 6-11-99

Existing System Inspection by: date

HEALTH DEPT COPY WHITE OWNER COPY (FINAL) YELLOW OWNER COPY (INITIAL) PINK