IREDELL COUNTY HEALTH DEPARTMENT

STATESVILLE 704-878-5305 MOORESVILLE 704-664-5281

IMPROVEMENT PERMIT / AUTHORIZATION TO CONSTRUCT / OPERATION PERMIT / EXISTING SYSTEM INSPECTION

PERMIT# 066707 PIN# 4893 70 7185

OWNER OR CONTRACTOR JIMMY TUCKER PHONE: Business (910) 463-2658 Home DATE 5-13-99

ADDRESS 2833 WYO ROAD, YADKINVILLE, NC 27055

LOCATION US 21 N, TR E. HOUSTONVILLE RD TR SANDY SPRINGS TL DOBY RD, 3RD LOT ON (R) PAST JOYNER

SUBDIVISION JIMMY TUCKER BLOCK / SECTION 1 LOT 3 1 LOT AREA 0.75 ACRE SITE CLASS PS DESIGN FLOW 360 L.T.A.R. 0.30 GPD/FT2

Septic Tank: 1000 Gallons; STB 238 Date 4-1-99

Pump Tank: ____ Gallons; PT ____ Date ____

Pump Make: ____ Model ____ Serial No. ____

Nitrification Field: No Fields 1 Square Feet EQ. TO 1200 Linear Feet 300 FT

No Lines FIVE Trench Width 36" Max Trench Bottom Depth 32"

~~New System~~ Repair System Type: I, II, III, IV, V, VI

System Description: 25% REDUCTION SYSTEM

Repair System Description: 50% REDUCTION SYSTEM

Maintenance Agreement Required: Yes ~~No~~

~~Gravel~~ Depth SAND 6" Slab ~~Crawl Space~~ Basement w/plumbing Basement wo/plumbing

~~House/Mod. Home~~ Mobile Home Business Other


No. Bedrooms 3 No. Bathrooms 2 No. Employees ____

Water Supply: ~~Individual~~ Public Community


Comments/Conditions: INSTALL 25% REDUCTION SYSTEM USING FIFTY (50) CHAMBERS OR THIRTY (30) H.D.S. SECTIONS

Comments/Conditions: LINES INSPECTED OK 6-7-99 RSH
SEPTIC TANK WITH RISERS AND "POLYLOK" FILTER INSTALLED

INITIAL SITE SKETCH SCALE: 1" = 40'

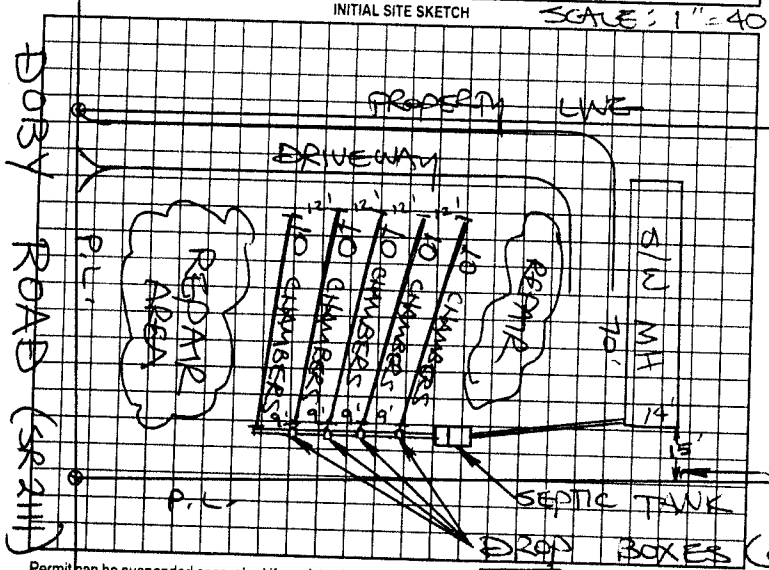

AS BUILT SKETCH

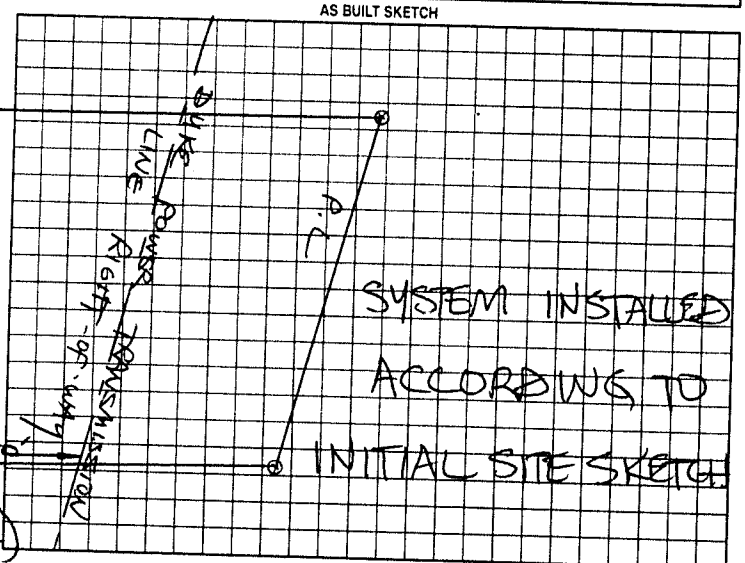

Permit can be suspended or revoked if any false information is supplied toward securing the permit/any unauthorized changes are made to the site/any unauthorized changes are made in the installation of the system. Improvement Permit with plat valid without expiration. Improvement Permit with site plan valid for sixty months. Authorization to Construct is valid for a period equal to that of Improvement Permit – not to exceed sixty months.

Signed: Jimmy W. Tucker date 5-17-99

Improvement Permit by: STEVE HEDRICK date 5-13-99

Authorization to Construct by: STEVE HEDRICK date 5-13-99

Installed by: COURTNEY GENERAL CONSTRUCTION

Operation Permit by: STEVE HEDRICK date 6-11-99

Existing System Inspection by: ____ date ____

HEALTH DEPT COPY WHITE OWNER COPY (FINAL) YELLOW OWNER COPY (INITIAL) PINK