IREDELL COUNTY HEALTH DEPARTMENT

STATESVILLE 704-878-5305 MOORESVILLE 704-664-5281

IMPROVEMENT PERMIT / AUTHORIZATION TO CONSTRUCT / OPERATION PERMIT / EXISTING SYSTEM INSPECTION

PERMIT# 14908 PIN# 4893709018 DATE 31 March 08

OWNER OR APPLICANT Jimmy Tucker PHONE: Business (336) 463-2658 Home (336) 468-7575

ADDRESS 2833 Hwy 601 Yadkinville NC 27055

LOCATION Sandy Springs RD (TR) Dilby 352 Dolby RD

SUBDIVISION _____ BLOCK / SECTION _____ LOT _____ LOT AREA 903 SITE CLASS. PS DESIGN FLOW 360 L.T.A.R. Existing

Septic Tank: 1000 Gallons; STB _____ Date _____

Pump Tank: _____ Gallons; PT _____ Date _____

Pump Make: _____ Model _____ Serial No. _____

Nitrification Field: No Fields ____ Square Feet Existing Linear Feet Existing

No Lines 2 Trench Width _____ Max Trench Bottom Depth _____ Gravel Depth _____

☒ New System ☐ Repair ☐ Expansion System Type: I (II) III IV V VI

System Description: Conventional Gravity

Repair System Description: _____

Maintenance Agreement Required: ☐ Yes ☒ No

☐ Gravity ☒ Pressure

☐ House/Mod. Home ☒ Mobile Home ☐ Business ☐ Other _____

No. Bedrooms 3 No. Persons ____ No. Employees ____


Water Supply: ☒ Individual ☐ Public ☐ Community

☐ Slab ☒ Crawl Space ☐ Basement w/plumbing ☐ Basement wo/plumbing


Comments:/Conditions:

Comments:/Conditions:

INITIAL SITE SKETCH

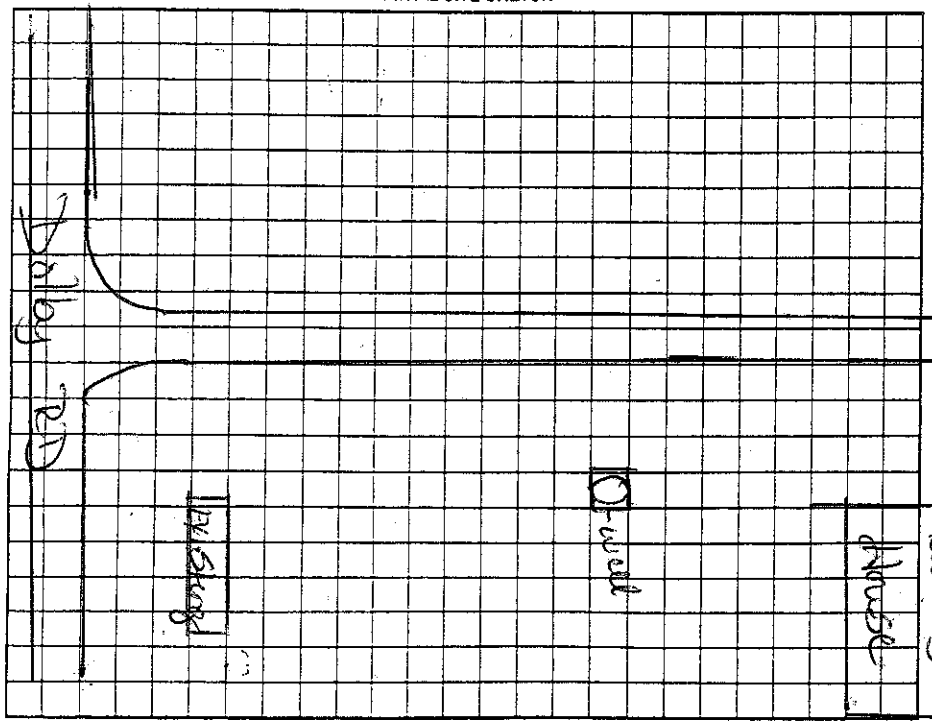

AS BUILT SKETCH

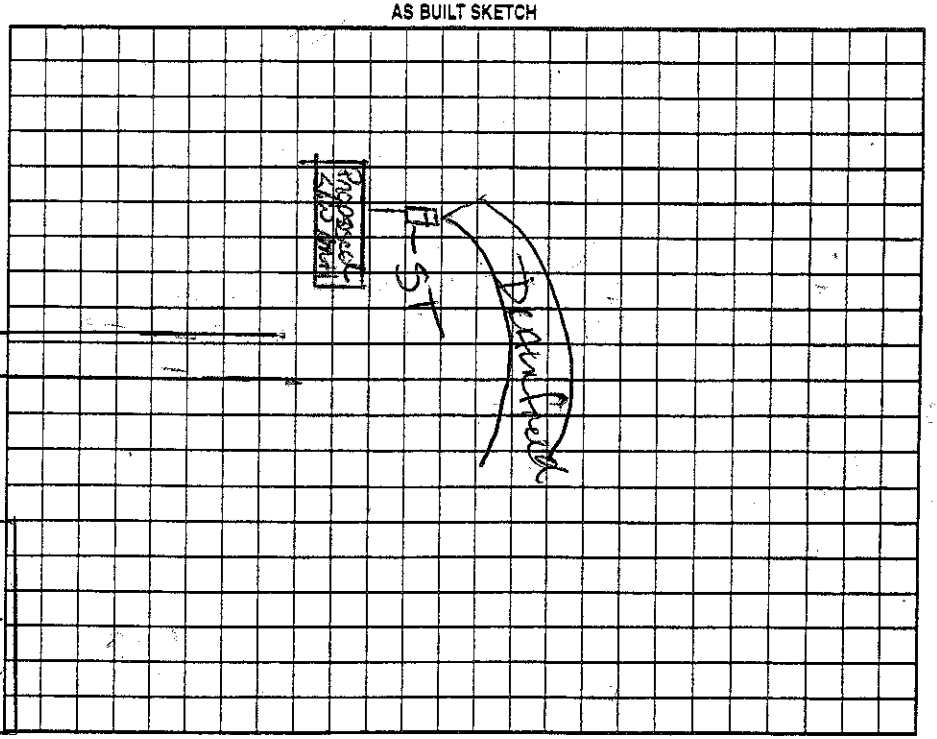

Permit can be suspended or revoked if any false information is supplied toward securing the permit/any unauthorized changes are made to the site/any unauthorized changes are made in the installation of the system. Improvement Permit with plat valid without expiration ☐ Improvement Permit with site plan valid for sixty months ☐ Authorization to Construct is valid for a period equal to that of Improvement Permit – not to exceed sixty months.

Signed: _____ date _____ Installed by: _____

Improvement Permit by: _____ date _____ Operation Permit by: _____ date _____

Authorization to Construct by: _____ date _____ Existing System Inspection by: Kurt Cook date 31 Mar 08

HEALTH DEPT. COPY: WHITE OWNER COPY (FINAL): YELLOW OWNER COPY (INITIAL): PINK