IREDELL COUNTY HEALTH DEPARTMENT

STATESVILLE 704-878-5305 MOORESVILLE 704-664-5281

IMPROVEMENT PERMIT / CERTIFICATE OF COMPLETION / OPERATION PERMIT / EXISTING SYSTEM INSPECTION

PROPERTY DESCRIPTION NO. 19361 DATE 12/8/94 TAX MAP NO. 17H-A-50 Watershed: ☐ Yes ☒ No

OWNER OR CONTRACTOR JIMMIE TUCKER PHONE: Business _____ Home 871-0502

ADDRESS P.O. BOX 6782, STATESVILLE, NC 28677

LOCATION US21 N, TR HOUSTONVILLE RD, TR SANDY SPRINGS RD, TL DOBY RD, 1ST DRIVE ON RIGHT PAST BOYER ROAD

SUBDIVISION _____ BLOCK / SECTION _____ LOT _____ LOT AREA _____ SITE CLASS. P3 DESIGN FLOW 240 L.T.A.R. EXISTING

Septic Tank: 1600 Gallons; STB _____ Date _____

Pump Tank: _____ Gallons; PT _____ Date _____

Pump Make: _____ Model _____ Serial No. _____

Nitrification Field: No Fields 1 Square Feet _____ Linear Feet EXISTING

No Lines _____ Trench Width _____ Max Trench Bottom Depth _____ Gravel Depth _____

☐ New System ☐ Repair System Type: (I), II, IV, V, VI

System Description: CONV. GRAVITY

Repair System Description: _____

Maintenance Agreement Required: ☐ Yes ☒ No

☐ Slab ☒ Crawl Space ☐ Basement w/plumbing ☐ Basement wo/plumbing

☐ House/Mod. Home No. Bedrooms 2

☒ Mobile Home No. Bathrooms 1

☐ Business No. Employees _____


☐ Other _____

Water Supply: ☒ Individual ☐ Community ☐ Public WELL


Comments:

Comments: MH ON SITE AT TIME OF INSPECTION

INITIAL SITE SKETCH

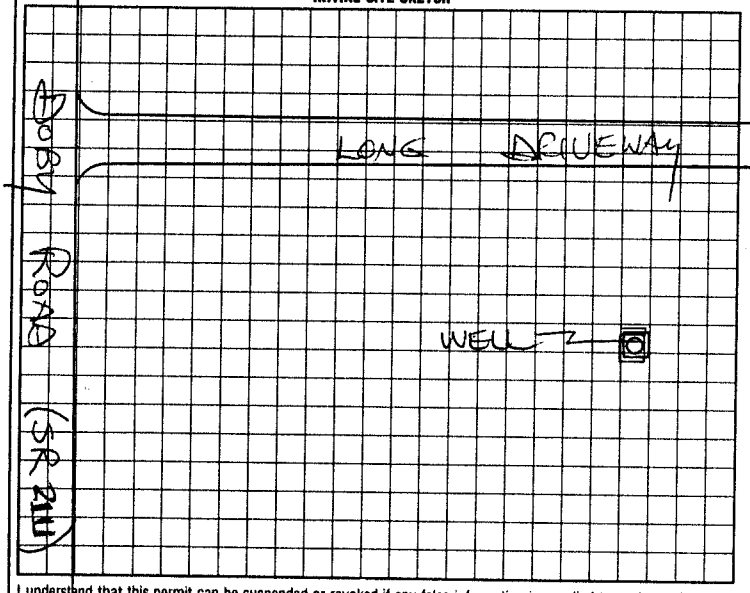

AS BUILT SKETCH

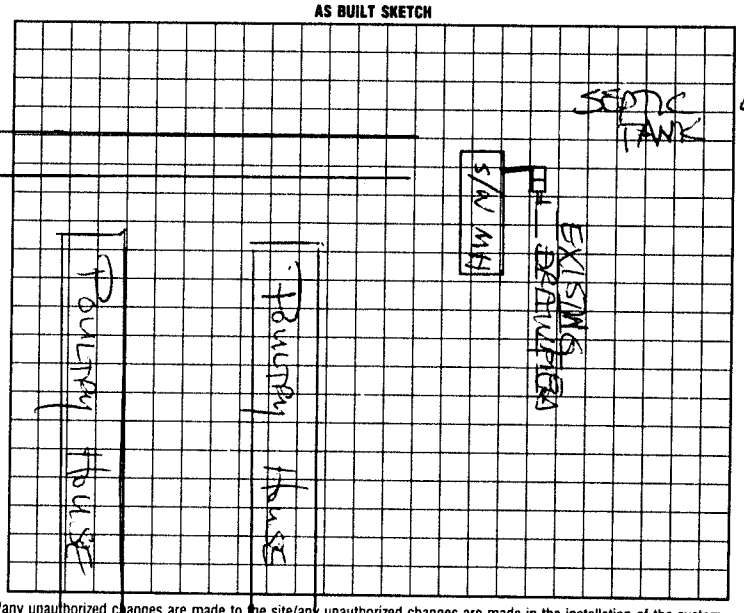

I understand that this permit can be suspended or revoked if any false information is supplied toward securing the permit/any unauthorized changes are made to the site/any unauthorized changes are made in the installation of the system. Improvement Permit is valid for 60 months from date of issuance.

Signed: _____

Improvement Permit by: _____ date _____

Existing System Inspection by: STEVE HEDRICK date 12/8/94

Installed by: _____

Certificate of Completion by: _____ date _____

Operation Permit by: _____ date _____

HEALTH DEPT. COPY: WHITE INSPECTION COPY (FINAL): GREEN OWNER COPY (FINAL): YELLOW INSPECTION COPY (INITIAL): PINK OWNER COPY (INITIAL): GOLD