IREDELL COUNTY HEALTH DEPARTMENT

STATESVILLE 704-878-5305 MOORESVILLE 704-664-5281

IMPROVEMENT PERMIT / CERTIFICATE OF COMPLETION / OPERATION PERMIT / EXISTING SYSTEM INSPECTION

PROPERTY DESCRIPTION NO. 20822 DATE 4/26/95 TAX MAP NO. 17H-A-50 Watershed: ☐ Yes ☐ No

OWNER OR CONTRACTOR Jimmy W. Tucker PHONE: Business _____ Home (910) 463-2658

ADDRESS 190 OLD STAGE RD YADKINVILLE NC 27055

LOCATION US 21N, TR Hamptonville Rd, TR Sandy Springs Rd TR Dobey Rd, 1st Drive in (R) past Lower Road

SUBDIVISION _____ BLOCK / SECTION _____ LOT _____ LOT AREA 13.33 AC SITE CLASS. P3 DESIGN FLOW 240 L.T.A.R. Existing

Septic Tank: Existing Gallons: STB _____ Date _____

Pump Tank: _____ Gallons; PT _____ Date _____

Pump Make: _____ Model _____ Serial No. _____

Nitrification Field: No Fields ___ Square Feet _____ Linear Feet Existing

No Lines _____ Trench Width _____ Max Trench Bottom Depth _____ Gravel Depth _____

☑ New System ☐ Repair System Type: ☐ I ☐ II ☐ III ☐ IV ☐ V ☐ VI

System Description: Conventional Gravity

Repair System Description: _____

Maintenance Agreement Required: ☐ Yes ☑ No

☐ House/Mod. Home ☑ Mobile Home ☐ Business ☐ Other

No. Bedrooms 2 No. Bathrooms 1 No. Employees ___


☐ Slab ☑ Crawl Space ☐ Basement w/plumbing ☐ Basement wo/plumbing

Water Supply: ☐ Individual ☐ Community ☐ Public Well


Comments:

Comments: Keep MH minimum 5' from system

INITIAL SITE SKETCH

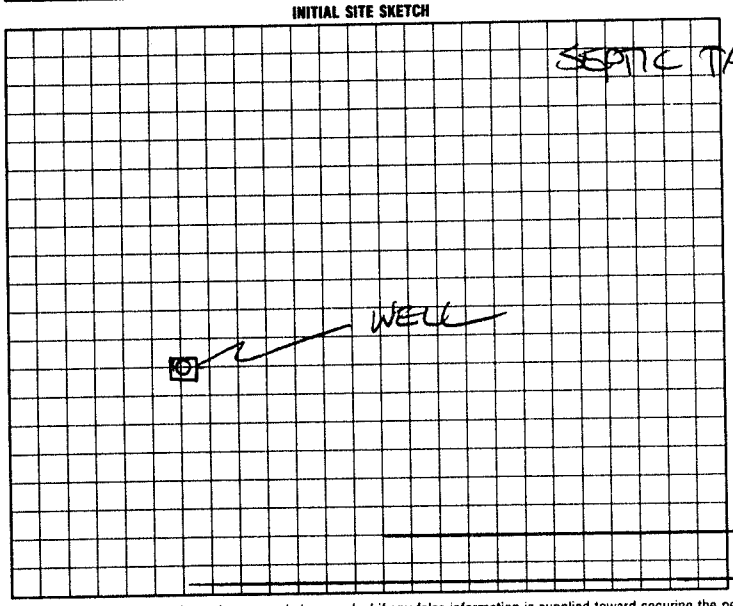

AS BUILT SKETCH

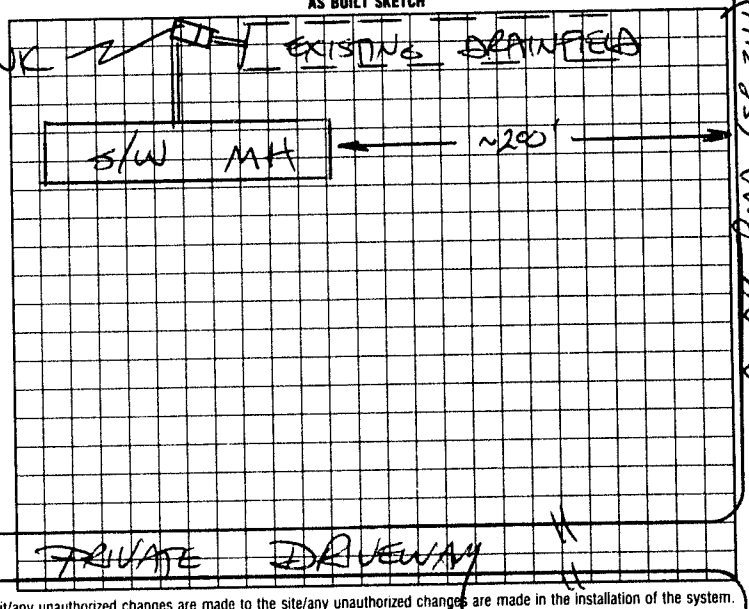

I understand that this permit can be suspended or revoked if any false information is supplied toward securing the permit/any unauthorized changes are made to the site/any unauthorized changes are made in the installation of the system. Improvement Permit is valid for 60 months from date of issuance.

Signed: _____

Improvement Permit by: _____ date _____

Existing System Inspection by: Steve Hedrick date 4/26/95

Installed by: _____

Certificate of Completion by: _____ date _____

Operation Permit by: _____ date _____

HEALTH DEPT. COPY: WHITE INSPECTION COPY (FINAL): GREEN OWNER COPY (FINAL): YELLOW INSPECTION COPY (INITIAL): PINK OWNER COPY (INITIAL): GOLD