IREDELL COUNTY HEALTH DEPARTMENT

Statesville Office (704) 878-5305 Mooresville Office (704) 660-3625 PERMIT # 217104

IMPROVEMENT PERMIT / AUTHORIZATION TO CONSTRUCT / OPERATION PERMIT / EXISTING SYSTEM

PIN # 4893-88-8421

APPLICANT: Malinda Eudaly APPLICANT ADDRESS: 487 Amberhill Rd. Mocksville NC

SITE ADDRESS: 485 Amberhill Rd Harmony NC Yadkinville PHONE: 336-492-6842 ALT. PHONE:

SITE DIRECTIONS: Hwy 21 Towards Harmony, Tr Houstonville Rd., Tr Sandy Springs Rd Tr Amberhill, site on L


SUBDIVISION: SECTION: LOT # LOT AREA: 4.587 Acres DESIGN FLOW: 480 GPD. L.T.A.R.: .3 I / .25 R

Septic Tank	1000 (gal)	STB 760	Date 7/1/16	☒ New System ☐ Repair ☐ Expansion	System Type: I II ☒III IV V VI	☒ Residence	No. Bedrooms 4	Water Supply
Pump Tank	(gal)	PT	Date	System Description: 25% Reduction - Gravity		☐ Business	No. Persons 8	☒ Private
Pump Make		Model	Serial #	Repair System Description: LP-PPBPS		☐ Other	No. Employees	☐ Public
# Nitrification Fields	1	# Lines 7	Linear Ft: 400'	Maintenance Agreement Required:	☐ YES ☒ NO	☐ Slab	☒ Crawl Space	☐ Community
Trench Width	36"	Max. Trench Bottom Depth 36"	Gravel Depth N/A	☒ GRAVITY	☐ PRESSURE	☐ Basement w/plumbing	☐ Basement w/o plumbing	


Comments / Conditions: Maintain 10' From Any Foundation Drain And 5' From Any Building Structure. Maintain 15' From 2' Cut (Gully).

* Deed Must Be Recorded w/ Proposed Property Lines Prior To Issuance Of AC. *

INITIAL SITE SKETCH

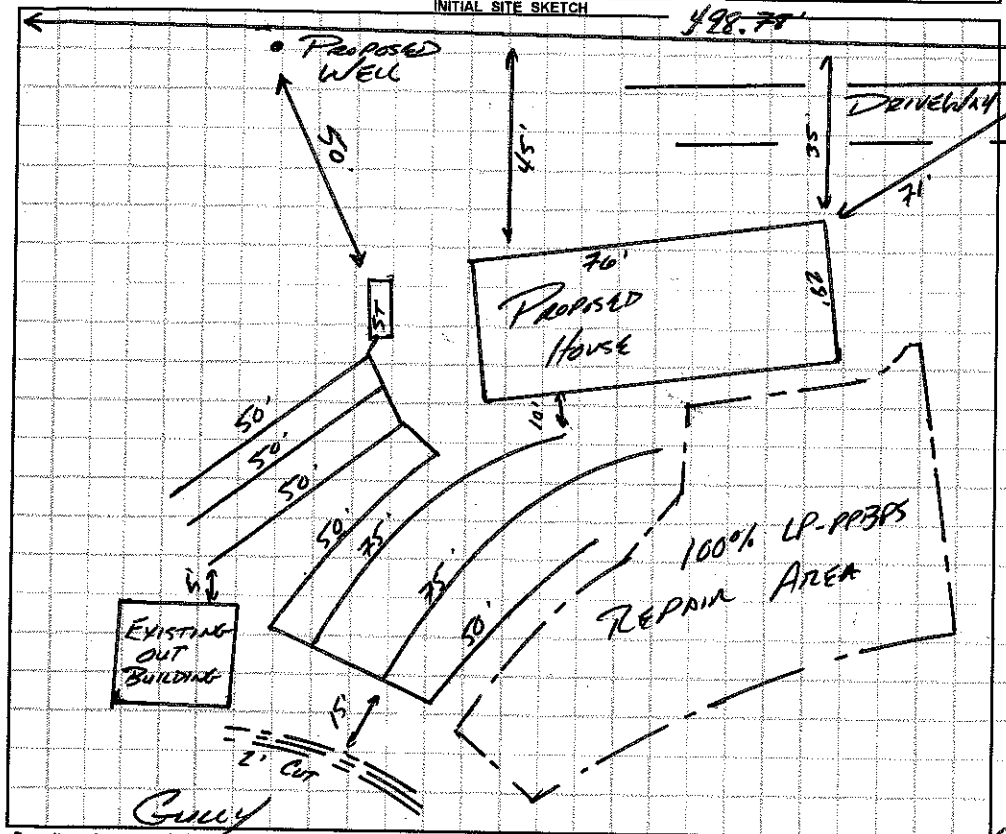

AS BUILT SKETCH

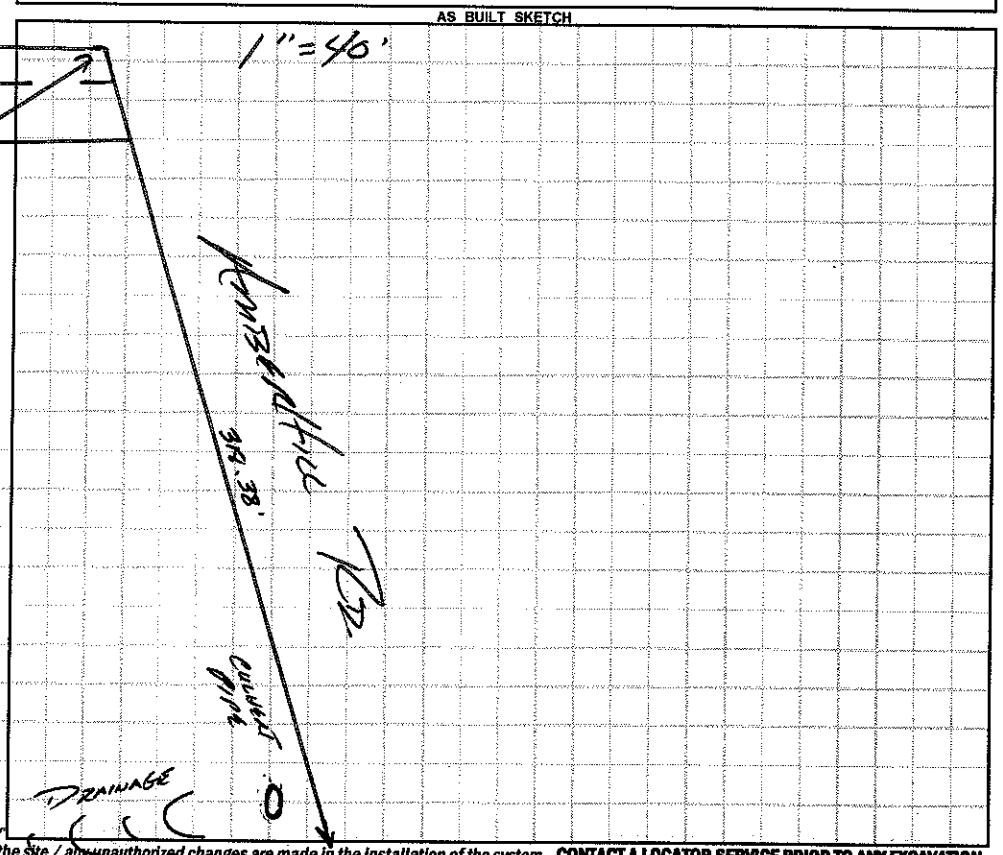

Permit can be suspended or revoked if any false information is supplied toward securing the permit / any unauthorized changes are made to the site / any unauthorized changes are made in the installation of the system. **CONTACT A LOCATOR SERVICE PRIOR TO ANY EXCAVATION**

☐ **IMPROVEMENT PERMIT** *with plat valid without expiration* ☒ **IMPROVEMENT PERMIT** *with site plan valid for 60 mos.* ☑ **AUTHORIZATION TO CONSTRUCT** *valid for period equal to IMPROVEMENT PERMIT--not to exceed 60 mo.*

Owner / Applicant Signature: Date: Installed by: A-1 Backhoe

IMPROVEMENT PERMIT by: APPROVED JUL 30 2016 OPERATION PERMIT by: W Sparks Date: 11/1/16

AUTHORIZATION TO CONSTRUCT by: Date: 10/12/16 Existing System Inspected by: Date:

Health Dept. Copy - WHITE Applicant (Final Approval) - YELLOW Applicant (Conditional Approval) - PINK