IREDELL COUNTY HEALTH DEPARTMENT

STATESVILLE 704-878-5305 MOORESVILLE 704-664-5281

IMPROVEMENT PERMIT / AUTHORIZATION TO CONSTRUCT / OPERATION PERMIT / EXISTING SYSTEM INSPECTION

PERMIT# 073229 PIN# 4893 29 6941 (PT) DATE

OWNER OR CONTRACTOR RAY WALL PHONE: Business Home: (336) 463-4283 (SISTER)

ADDRESS 3033 SANDY SPRINGS ROAD, HARMONY NC 28634

LOCATION US 21 N, TR E. HOUSTONVILLE ROAD, TL SANDY SPRINGS ROAD, ~ 1.8 MILE ON LEFT, 550' OFF ROAD

SUBDIVISION BLOCK / SECTION LOT LOT AREA 2 ACRES SITE CLASS. PS DESIGN FLOW 240 L.T.A.R. 0.30 GPD/FT2

Septic Tank: 1000 Gallons; STB 620/928 Date 5-6-98
Pump Tank: Gallons; P.T Date
Pump Make: Model Serial No.
Nitrification Field: No Fields 1 Square Feet 810 Linear Feet 270
No Lines THREE Trench Width 36" Max Trench Bottom Depth 36" Gravel Depth 12"

☑ New System ☐ Repair System Type: I, (II), III, IV, V, VI
System Description: CONVENTIONAL GRAVITY
Repair System Description: CONV. GRAVITY
Maintenance Agreement Required: ☐ Yes ☑ No


☐ House/Mod. Home No. Bedrooms 2
☑ Mobile Home No. Bathrooms 1
☐ Business No. Employees
☐ Other
☐ Slab ☑ Crawl Space ☐ Basement w/plumbing ☐ Basement wo/plumbing

Water Supply: ☑ Individual ☐ Public ☐ Community
WELL


Comments:/Conditions: INSTALL LINES ON CONTOUR AS FLAGGED

Comments:/Conditions:

INITIAL SITE SKETCH ~SCALE: 1" = 50'

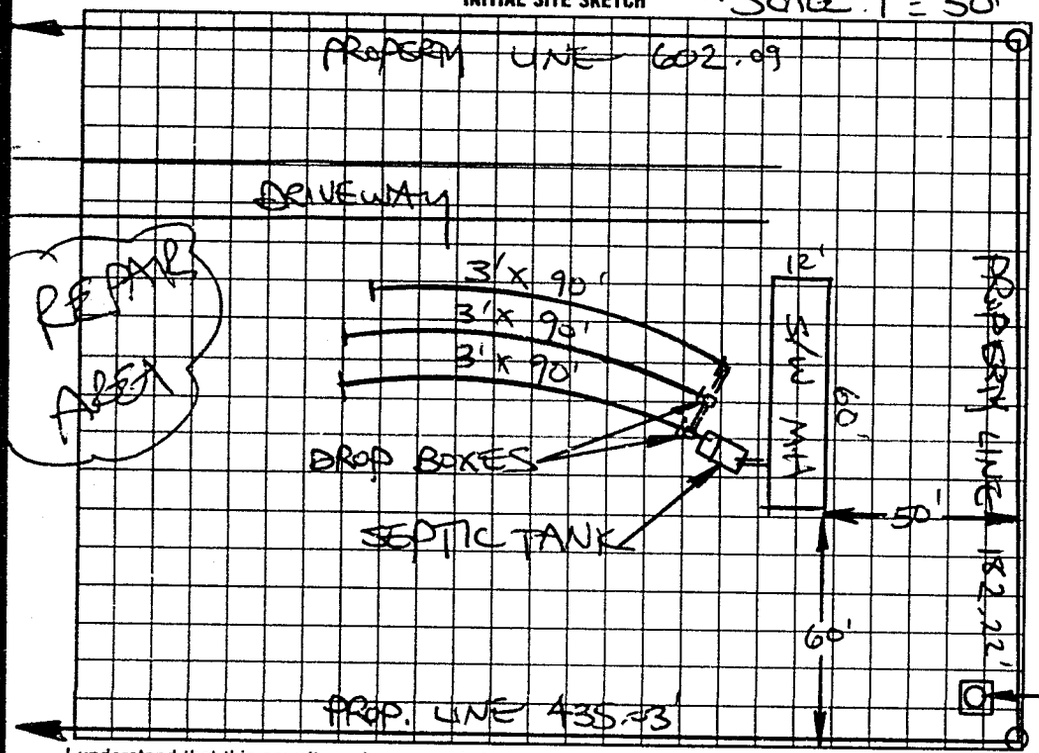

AS BUILT SKETCH

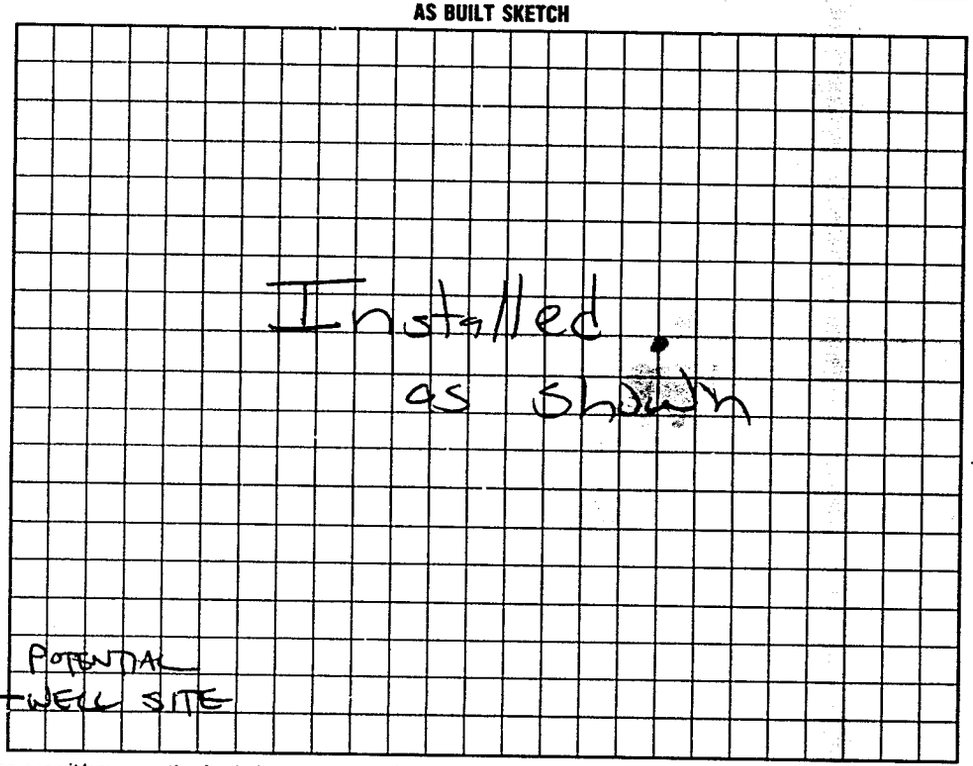

I understand that this permit can be suspended or revoked if any false information is supplied toward securing the permit/any unauthorized changes are made to the site/any unauthorized changes are made in the installation of the system. Improvement Permit with plat valid without expiration. Improvement Permit with site plan valid for sixty months. Authorization to Construct is valid for a period equal to that of Improvement Permit – not to exceed sixty months.

Signed: X Ray Wall date 5.18.98

Improvement Permit by: STEVE HEDRICK date 5-18-98

Authorization to Construct by: STEVE HEDRICK date 5-18-98

Installed by: Tommy Wixon

Operation Permit by: [illegible] date 6-3-98

Existing System Inspection by: date

HEALTH DEPT. COPY: WHITE INSPECTION COPY (FINAL): GREEN OWNER COPY (FINAL): YELLOW INSPECTION COPY (INITIAL): PINK OWNER COPY (INITIAL): GOLD