IREDELL COUNTY HEALTH DEPARTMENT

Statesville Phone TR 3-7271 Mooresville Phone MO 3-1271

PERMIT TO INSTALL SEPTIC TANK

Permit No. _____ Permit Date 3-8 19 66

Owner Mr Wilson ? Address R+ 2 Harmony NC

Installed By Paul Moore Address Harmony, NC.


Location of Property Hwy 21 R/ Love Station Rd. past Bud Cooper Dairy Yard on left before Rd. No 2107

Tank		Capacity		Length of Lines		Fixtures	
Block	( )	1000	( )	225'	( )	No. of Baths	( )
Precast	( )	1250	( )	250'	( )	Dishwasher	( )
		1500	( )	Other _____		Garbage Grdr.	( )
		Other _____				Other _____	

NOTIFY HEALTH DEPARTMENT AT LEAST EIGHT HOURS BEFORE TANK IS TO BE INSPECTED.

Final Inspection 3-8 19 66 Approved (✓) Disapproved ( )

Remarks _____

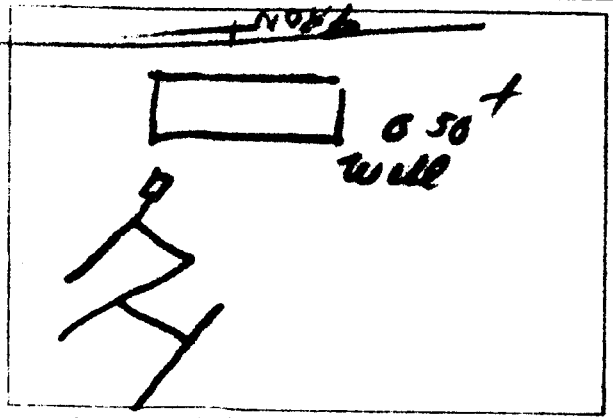

Plan of Installation

Sanitarian